

W - 3.66
S - 2.60

New Location
 Drill Deeper
 Abandonment Ft

Company William Mosses
 Address 189 W. Main St. Salem, W. Va.
 Farm L. M. Allen
 Tract _____ Acres 55 1/4 Lease No. _____
 Well (Farm) No. One Serial No. _____
 Elevation (Spirit Level) 971
 Quadrangle Centerpoint
 County Doddridge District McClellan
 Engineer A. K. Westfall
 Engineer's Registration No. Deputy Co. Surveyor, Ritchie Co.
 File No. _____ Drawing No. _____
 Date Dec 16, 1920 Scale 1" = 30 Feet

STATE OF WEST VIRGINIA
 DEPARTMENT OF MINES
 OIL AND GAS DIVISION
 CHARLESTON

WELL LOCATION MAP
 FILE NO. DOD-356A

+ Denotes location of well on United States Topographic Maps, scale 1 to 62,500, latitude and longitude lines being represented by border lines as shown
 - Denotes one inch spaces on border line of original tracing.

STATE OF WEST VIRGINIA
DEPARTMENT OF MINES
OIL AND GAS DIVISION

288

WELL RECORD


AB 356 A

Permit No. _____

Oil or Gas Well (Kind) Oil

Company <u>William Moses</u>	Casing and Tubing	Used in Drilling	Left in Well	Packers
Address <u>189 W. Main St., Salem, W. Va.</u>	Size			
Farm <u>L. M. Allen</u> Acres <u>55 1/2</u>	16			Kind of Packer
Location (waters)	13			
Well No. <u>One</u> Elev. <u>971</u>	10			Size of
District <u>McClellan</u> County <u>Doddridge</u>	8 1/4		<u>1238</u>	
The surface of tract is owned in fee by <u>Wm. Droppleman</u>	6 5/8		<u>2230</u>	Depth set
<u>West Union, W. Va.</u> Address _____	5 3/16			
Mineral rights are owned by <u>L. M. Allen</u>	3			Perf. top
<u>Center point</u> Address <u>West Virginia</u>	2		<u>2280</u>	Perf. bottom
Drilling commenced _____	Liners Used _____			Perf. top
Drilling completed _____				Perf. bottom
Date shot _____ Depth of shot _____				
Open Flow /10ths Water in _____ Inch				
/10ths Merc. in _____ Inch				
Volume _____ Cu. Ft.	CASING CEMENTED _____	SIZE _____	No. Ft. _____	Date _____
Rock Pressure _____ lbs _____ hrs.				
Oil _____ bbls., 1st 24 hrs.	COAL WAS ENCOUNTERED AT <u>780</u> FEET	<u>3/6</u> INCHES		
Fresh water _____ feet	_____ FEET _____ INCHES	_____ FEET _____ INCHES		
Salt water _____ feet	_____ FEET _____ INCHES	_____ FEET _____ INCHES		

Formation	Color	Hard or Soft	Top	Bottom	Oil, Gas or Water	Depth Found	Remarks
Pittsburg	Coal		780	783			
Little Dunkard			1090	1155			
Big Dunkard			1213	1248	No Coal Operations in this Area.		
Gas Sand			1400	1448			
First Salt Sand			1460	1540			
Second Salt Sand			1685	1778			
Maxon			1980	1992			
Little Lime			2097	2110			
Pencil Cave			2126	2130			
Big Lime			2130	2200			
Big Injun			2200	2250			
Squaw (Oil)			2285	2292			
Total Depth			2300				

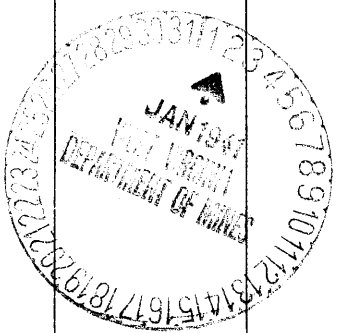

(Over)

JAN - 8 1911