


Latitude 35° 20'

Longitude 80° 35'

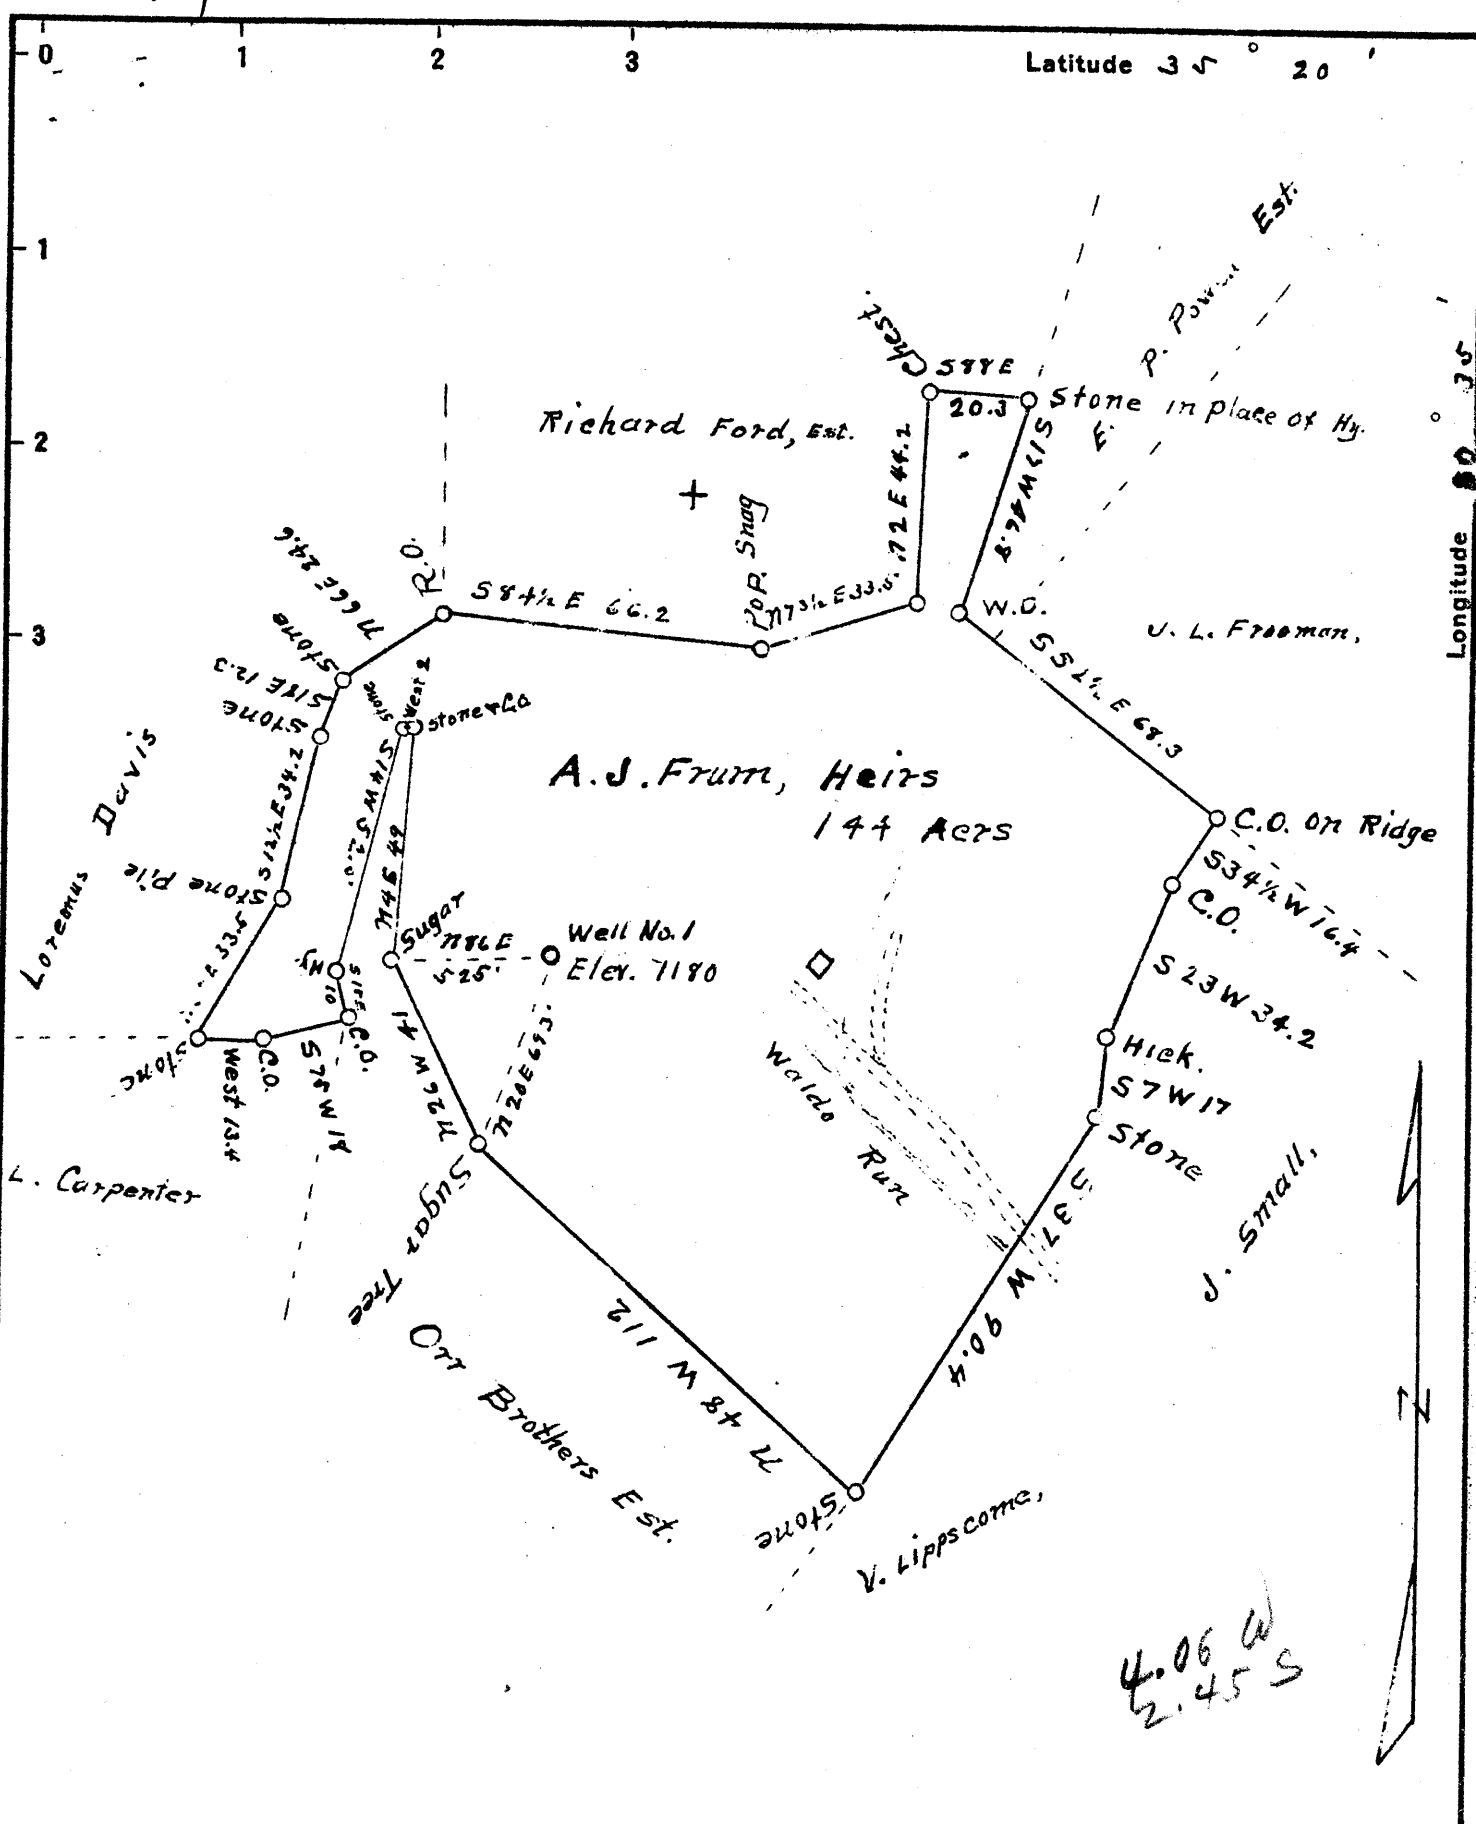

4.06 W
2.45 S

- New Location
- Drill Deeper
- Abandonment ✓

Company Radd Supply Co.
 Address Salern, W. Va.
 Farm A. J. FRUM, HTS.
 Tract ONE Acres 144 Lease No. _____
 Well (Farm) No. ONE Serial No. _____
 Elevation (Spirit Level) 1180
 Quadrangle Center Point
 County Loddrige District Grant
 Engineer J. M. Martin
 Engineer's Registration No. 84
 File No. _____ Drawing No. _____
 Date April 1941 Scale 40 P = One Inch

STATE OF WEST VIRGINIA
 DEPARTMENT OF MINES
 OIL AND GAS DIVISION
 CHARLESTON

WELL LOCATION MAP
 FILE NO. DOD-359A
 (was: 01772667)

+ Denotes location of well on United States Topographic Maps, scale 1 to 62,500, latitude and longitude lines being represented by border lines as shown.

- Denotes one inch spaces on border line of original tracing.