


Latitude 39° 15'

Longitude 80° 40'

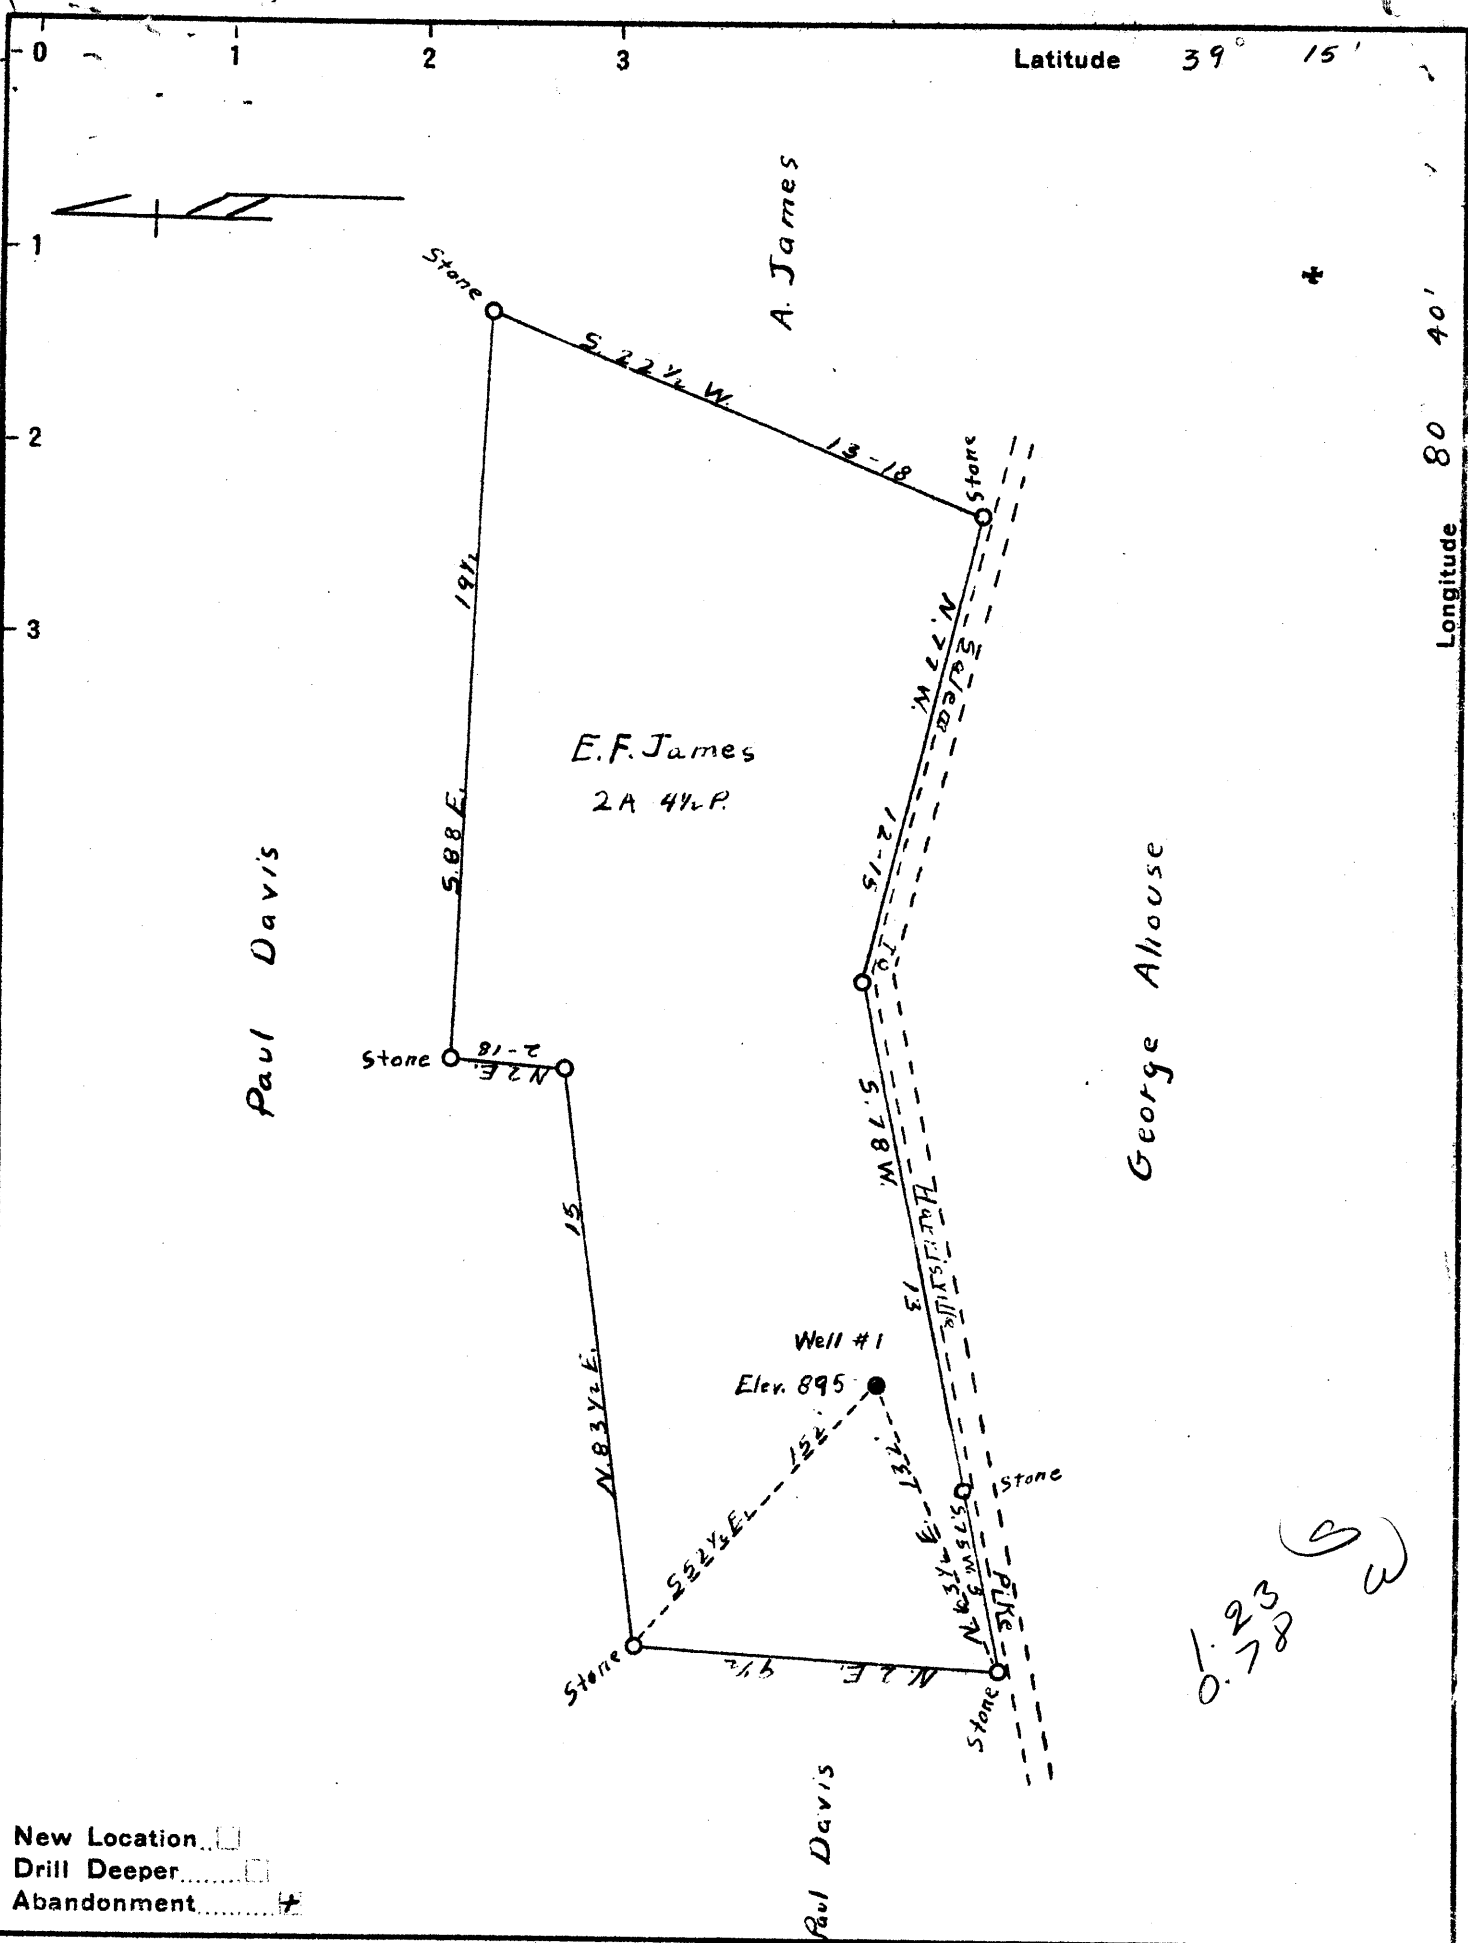

1.23
0.78
(S)
(W)

New Location
 Drill Deeper
 Abandonment

Company William Moses
 Address 189 W. Main St. Salem, W. Va.
 Farm E. F. James
 Tract _____ Acres 2A 4 1/2 P Lease No. _____
 Well (Farm) No. One Serial No. _____
 Elevation (Spirit Level) 895.
 Quadrangle Vadis
 County Doddridge District Mew Milton
 Engineer A. K. Westfall
 Engineer's Registration No. Ca. Surveyor, Ritchie Co.
 File No. _____ Drawing No. _____
 Date Aug. 19 1941 Scale 1" = 5 Poles

STATE OF WEST VIRGINIA
 DEPARTMENT OF MINES
 OIL AND GAS DIVISION
 CHARLESTON

WELL LOCATION MAP
 FILE NO. DOD-371A

+ Denotes location of well on United States Topographic Maps, scale 1 to 62,500, latitude and longitude lines being represented by border lines as shown.
 - Denotes one inch spaces on border line of original tracing.

STATE OF WEST VIRGINIA
DEPARTMENT OF MINES
OIL AND GAS DIVISION

WELL RECORD

309

Permit No. 391-A

Oil or Gas Well Oil
(Kind)

Company <u>William Moses</u>	Casing and Tubing	Used in Drilling	Left in Well	Packers
Address <u>189 W. Main St., Salem, W. Va.</u>	Size			
Farm <u>E. F. James</u> Acres <u>2A-4 1/2 P.</u>				
Location (waters)	16			Kind of Packer
Well No. <u>One</u> Elev. <u>895</u>	13			
District <u>New Milton</u> County <u>Doddridge</u>				Size of
The surface of tract is owned in fee by <u>William Droppleman,</u>			<u>1064</u>	Depth set
Address <u>West Union, W. Va.</u>			<u>1867</u>	
Mineral rights are owned by <u>Elizabeth S. James, Hrs. 6%</u>	<u>5 3/16</u>			Perf. top
<u>A. R. James,</u> Address <u>New Milton, W. Va.</u>				Perf. bottom
Drilling commenced	<u>3</u>			Perf. top
Drilling completed	<u>2</u>		<u>1977</u>	Perf. bottom
Date shot	Liners Used			Perf. top
Open Flow /10ths Water in				Perf. bottom
/10ths Merc. in				
Volume Cu. Ft.	CASING CEMENTED	SIZE	No. Ft.	Date
Rock Pressure lbs. hrs.				
Oil bbls., 1st 24 hrs.	COAL WAS ENCOUNTERED AT	<u>530</u>	FEET	INCHES
Fresh water feet			FEET	INCHES
Salt water feet			FEET	INCHES

Formation	Color	Hard or Soft	Top	Bottom	Oil, Gas or Water	Depth Found	Remarks
Pitts. Coal			530	536			
Big Shankard			1050	1130			
1st salt sand			1295	1335			
2nd "	"		1340	1515			
3rd "	"		1630	1670			
little lime			1835	1850			
Big Lime			1920	1955			
big Injun			1955	2021			
Total depth				2026			

