


m

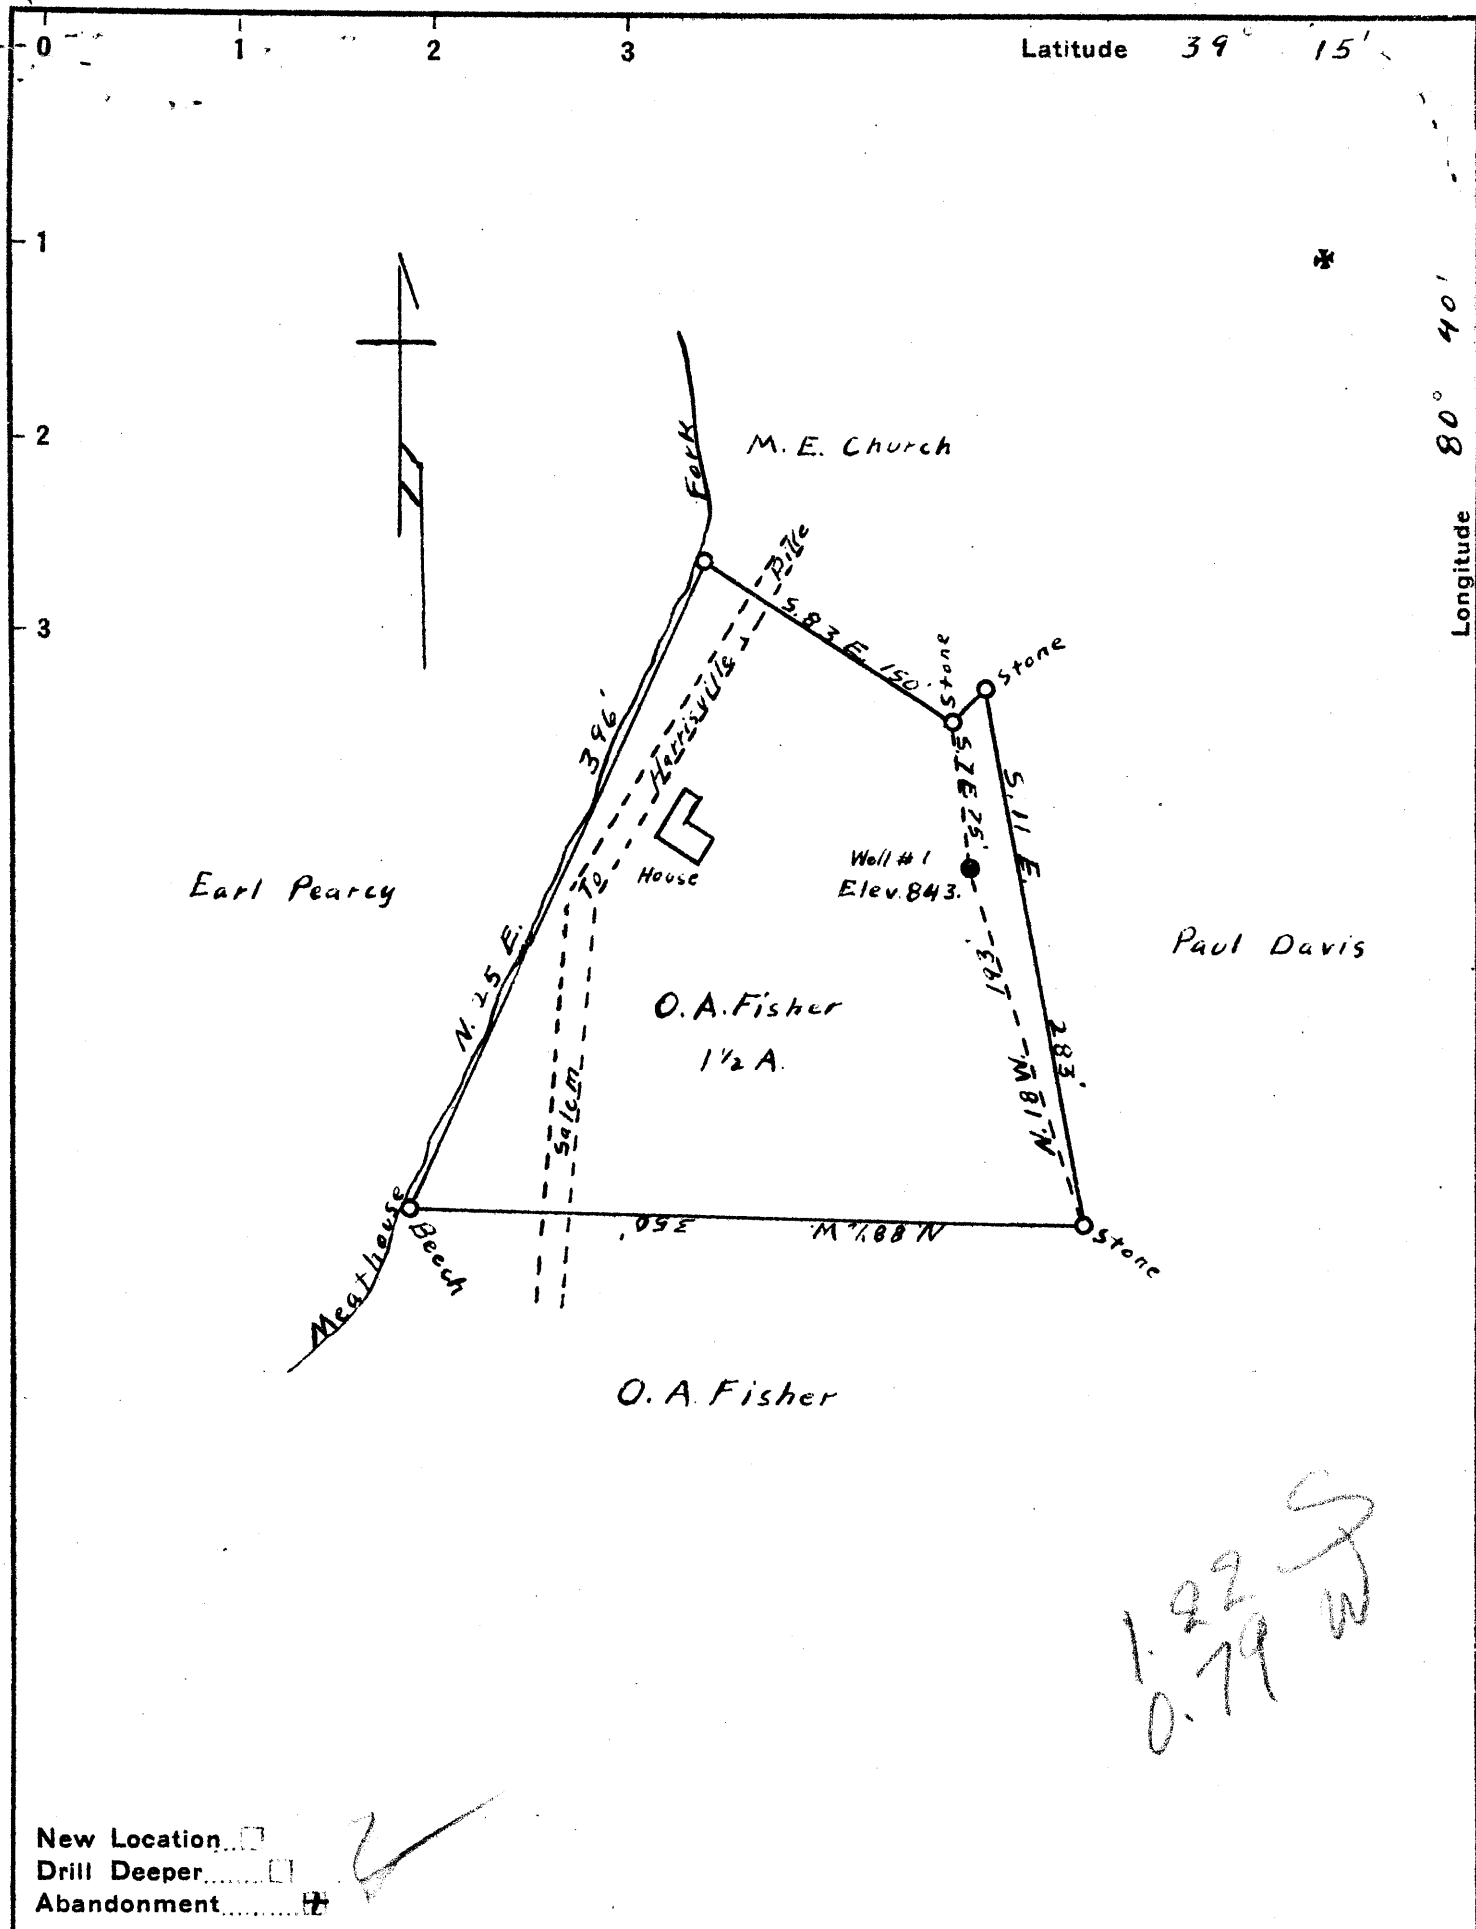

1.82
0.79 W

New Location
 Drill Deeper
 Abandonment

Company William Moses
 Address 189 W. Main St. Salem, W. Va.
 Farm O. A. Fisher
 Tract _____ Acres 1 1/2 Lease No. _____
 Well (Farm) No. One Serial No. _____
 Elevation (Spirit Level) 843.
 Quadrangle Vadis
 County Doddridge District New Milton
 Engineer A. K. Westfall
 Engineer's Registration No. Co. Surveyor, Ritchie, Co.
 File No. _____ Drawing No. _____
 Date Aug 19 1941 Scale 1" = 100'

STATE OF WEST VIRGINIA
 DEPARTMENT OF MINES
 OIL AND GAS DIVISION
 CHARLESTON

WELL LOCATION MAP
 FILE NO. DOD-372A

+ Denotes location of well on United States Topographic Maps, scale 1 to 62,500, latitude and longitude lines being represented by border lines as shown.

- Denotes one inch spaces on border line of original tracing.

STATE OF WEST VIRGINIA
DEPARTMENT OF MINES
OIL AND GAS DIVISION

WELL RECORD

Permit No. 372-A

Oil or Gas Well Oil
(KIND)

Company William Moses
 Address 189 W. Main St., Salem, W. Va.
 Farm O. A. Fisher Acres 1-1/2
 Location (waters) _____
 Well No. One Elev. 843
 District New Milton County Doddridge
 The surface of tract is owned in fee by William Droppleman
 Address West Union, W. Va.
 Mineral rights are owned by O. A. Fisher
 Address New Milton, W. Va.
 Drilling commenced _____
 Drilling completed _____
 Date shot _____ Depth of shot _____
 Open Flow /10ths Water in _____ Inch
 /10ths Merc. in _____ Inch
 Volume _____ Cu. Ft. CASING CEMENTED SIZE _____ No. Ft. _____ Date _____
 Rock Pressure _____ lbs _____ hrs.
 Oil _____ bbls., 1st 24 hrs. COAL WAS ENCOUNTERED AT 490 FEET INCHES
 Fresh water _____ feet _____ feet
 Salt water _____ feet _____ feet

Casing and Tubing	Used in Drilling	Left in Well	Packers
Size			Kind of Packer
16.			
13.		<u>40</u>	
10.		<u>435</u>	Size of
8 1/4			
6 1/2		<u>1800</u>	Depth set
5 3/16			
3.			Perf. top
2.		<u>1945</u>	Perf. bottom
Liners Used			Perf. top
			Perf. bottom

Formation	Color	Hard or Soft	Top	Bottom	Oil, Gas or Water	Depth Found	Remarks
Pitts. Coal			490	500			
Big Dunkard			1000	1050			
1st Salt Sand			1230	1260			
2nd " "			1300	1370			
3rd " "			1380	1490			
Little Lime			1770	1800			
Big Lime			1810	1886			
Big Injun			1886	1846			
Total Depth				1955			

