

Coal & Surface:  
 Laura Knight  
 c/o Estella Knight, Agent  
 West Union, W. Va.  
 R.D. No. 2.

Handwritten notes and calculations:

3 } 3.58 S W  
 4 } 4.36 W  
 5 } 3.62 S W  
 8 } 4.48 W

Wm. Booher calc. 15 loc clc 115/100  
 3.505  
 4.29 W

30378      30379  
 7.5' loc      7.5' loc  
 0.63 S 392233      0.65 S 392230  
 2.05 W 804230      2.16 W 804230

3.535  
 4.39 W  
 S6 W 7-8      MOD N37

New Location   
 Drill Deeper   
 Abandonment

Company South Penn Natural Gas Co.  
 Address Parkersburg, W. Va.  
 Farm Henry Knight  
 Tract \_\_\_\_\_ Acres 186 Lease No. 897  
 Well (Farm) No. 3 & 5 Serial No. \_\_\_\_\_  
 Elevation (Spirit Level) 3=1190.55 5=946.57  
 Quadrangle Centerpoint  
 County Doddridge District Grant  
 Engineer Emmon Haines  
 Engineer's Registration No. \_\_\_\_\_  
 File No. \_\_\_\_\_ Drawing No. \_\_\_\_\_  
 Date Sept. 11, 1941 Scale 1" = 400'

STATE OF WEST VIRGINIA  
 DEPARTMENT OF MINES  
 OIL AND GAS DIVISION  
 CHARLESTON

WELL LOCATION MAP  
 FILE NO. DOD-378A & 379A  
 3  
 5  
 Wad 01792963

+ Denotes location of well on United States Topographic Maps, scale 1 to 62,500, latitude and longitude lines being represented by border lines as shown.

- Denotes one inch spaces on border line of original tracing.

DODD-378A & 379A

STATE OF WEST VIRGINIA  
DEPARTMENT OF MINES  
OIL AND GAS DIVISION

311

WELL RECORD

OIL

Oil or Gas Well.....  
(Kind)

Permit No. 379-A

Company South Penn Natural Gas Company  
 Address Union Trust Bldg. Parkersburg, W. Va.  
 Farm Henry Knight Acres 186  
 Location (waters).....  
 Well No. 5 Elev. 948.57  
 District Grant County Doddridge  
 The surface of tract is owned in fee by Laura Knight  
c/o Estelia Knight, 72 West Union, W. Va.  
 Mineral rights are owned by Laura Knight et al  
Washington, W. Va.  
 Drilling commenced Dec. 3, 1894  
 Drilling completed Jan. 18, 1895  
 Date shot See below Depth of shot.....  
 Open Flow /10ths Water in..... Inch  
 /10ths Merc. in..... Inch  
 Volume..... Cu. Ft.  
 Rock Pressure..... lbs..... hrs.  
 Oil 50..... bbls., 1st 24 hrs.  
 Fresh water..... feet..... feet  
 Salt water..... feet..... feet


Casing and Tubing	Used in Drilling	Left in Well	Packers
Size			
16.....			Kind of Packer.....
13.....			
10.....			Size of.....
8 1/4.....	<u>1084</u>		
6%.....	<u>1971'10"</u>		Depth set.....
5 3/16.....			
3.....			Perf. top.....
2.....			Perf. bottom.....
Liners Used			Perf. top.....
Cond. <u>18'</u>			Perf. bottom.....

CASING CEMENTED..... SIZE..... No. Ft..... Date.....  
 COAL WAS ENCOUNTERED AT 630 FEET 80 INCHES  
 FEET..... INCHES..... FEET..... INCHES  
 FEET..... INCHES..... FEET..... INCHES

Formation	Color	Hard or Soft	Top	Bottom	Oil, Gas or Water	Depth Found	Remarks
Pittsburgh Coal			630	635			
Big Injun			1965		1st Pay 2nd Pay	2046 2052	
Total Depth				2067			

SHOT RECORD:

11	-	23	-	96	16	Qt.
8	-	18	-	00	20	"
5	-	25	-	03	30	"
4	-	15	-	05	40	"
6	-	17	-	08	60	"

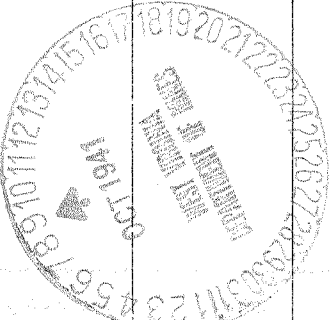

870-21011

