

New Location   
 Drill Deeper   
 Abandonment

Company PITTSBURGH & W.VA. GAS CO.  
 Address CLARKSBURG, W.VA.  
 Farm W.L. COTTRILL ET UX  
 Tract \_\_\_\_\_ Acres 127 Lease No. 4262  
 Well (Farm) No. ONE Serial No. 4370  
 Elevation (Spirit Level) 1158' KA.  
 Quadrangle CENTERPOINT S. W. 22  
 County DODDRIDGE District McCLELLAN  
 Engineer James D. Jeffries  
 Engineer's Registration No. 1084  
 File No. V-101-P-87 Drawing No. \_\_\_\_\_  
 Date APRIL 16, 1942 Scale 1" = 500'

STATE OF WEST VIRGINIA  
 DEPARTMENT OF MINES  
 OIL AND GAS DIVISION  
 CHARLESTON

**WELL LOCATION MAP**  
 FILE NO. DOD-393-A

+ Denotes location of well on United States Topographic Maps, scale 1 to 62,500, latitude and longitude lines being represented by border lines as shown.

- Denotes one inch spaces on border line of original tracing.

AL

STATE OF WEST VIRGINIA  
DEPARTMENT OF MINES  
OIL AND GAS DIVISION

317

WELL RECORD

Permit No. 3930A


Oil or Gas Well GAS  
(KIND)

Company Pittsburgh & West Va. Gas Company.  
Address Glastonbury, West Va.  
Farm W. L. Cottrell Acres 127  
Location (waters) Opt. S/W, 2-2  
Well No. 1270 Elev. 1158' VA  
District McClallen County Dodridge  
The surface of tract is owned in fee by Randolph Baker  
Centerpoint, Address West Va.  
Mineral rights are owned by F. H. Cottrell et al  
Address Salon, W. Va.  
Drilling commenced July 22, 1915  
Drilling completed August 22, 1915  
Date shot \_\_\_\_\_ Depth of shot \_\_\_\_\_  
Open Flow /10ths Water in \_\_\_\_\_ Inch  
/10ths Merc. in \_\_\_\_\_ Inch  
Volume \_\_\_\_\_ Cu. Ft.  
Rock Pressure \_\_\_\_\_ lbs \_\_\_\_\_ hrs.  
Oil \_\_\_\_\_ bbls., 1st 24 hrs.  
Fresh water \_\_\_\_\_ feet \_\_\_\_\_ feet  
Salt water \_\_\_\_\_ feet \_\_\_\_\_ feet

Casing and Tubing	Used in Drilling	Left in Well	Packers
Size			
16			Kind of Packer
13			<u>Bottom Hole.</u>
10	<u>107'</u>	<u>Pulled.</u>	Size of <u>8-1/4" X</u>
8 1/4	<u>1251'</u>	<u>1251'</u>	<u>6-5/8"</u>
6 5/8	<u>2116'</u>	<u>2116'</u>	Depth set <u>2116'</u>
5 3/16			
3			Perf. top _____
2			Perf. bottom _____
Liners Used			Perf. top _____
			Perf. bottom _____

CASING CEMENTED \_\_\_\_\_ SIZE \_\_\_\_\_ No. Ft. \_\_\_\_\_ Date \_\_\_\_\_  
COAL WAS ENCOUNTERED AT 300 FEET 36 INCHES  
770 FEET 72 INCHES FEET \_\_\_\_\_ INCHES  
FEET \_\_\_\_\_ INCHES FEET \_\_\_\_\_ INCHES

Formation	Color	Hard or Soft	Top	Bottom	Oil, Gas or Water	Depth Found	Remarks
Un-Recorded			0	255			
Sand	White	Hard	255	280			
Slate	"	Soft	280	300			
Sand	"	"	300	325			
Red Rock	Red	Medium	325	402			
Slate-Lime	White	"	402	473			
Sand	"	Hard	473	500			
Coal			500	509			
Lime	White	Hard	509	573			
Black-shale	Black-Red	Soft	573	585			
Stuff Sand	White	Hard	585	604			
Lime	"	"	604	640			
Thin Sand	"	"	640	645			
Lime	"	"	645	770			
Fgh. Coal			770	776			
Slate-Lime	White	Medium	776	820			
Murphy Sand	"	Hard	820	850			
Red Rock	Red	Medium	850	915			
Sand	White	Hard	915	920			
Red Rock	Red	Soft	920	936			
Lime	White	Hard	936	970			
Red Rock	Red	Soft	970	1030			
Slate	White	"	1030	1045			
Red Rock	Red	"	1045	1105			
Little Diamond	White	Hard	1105	1145			
Slate-Lime	White	Medium	1145	1185			
Lime	Dark	Soft	1185	1200			
Slate	White	"	1200	1220			
Slate	Black	"	1220	1242			
Big Diamond	White	Hard	1242	1260			
Slate	Black	Soft	1260	1285			
Slate-Lime	White	Medium	1285	1345			
Lime	"	Hard	1345	1385			
Gas Sand	"	"	1385	1392			
Slate-Lime	"	Medium	1392	1545			
1st. Salt Sand	Dark	Hard	1545	1585			
Slate-Lime	Black	Medium	1585	1620			
2nd. Salt Sand	Dark	Hard	1620	1652			
Slate-Lime	"	Medium	1652	1670			
3rd. Salt Sand	White	Hard	1670	1850	Water	1680-90	
Slate-Lime Shells	"	Medium	1850	2005	"	1700'	9 Sallows Hr.

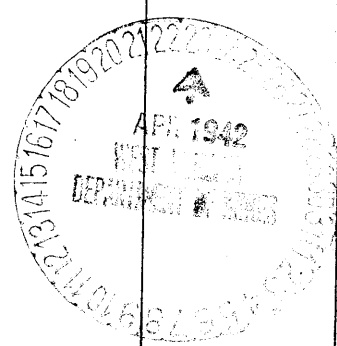

Formation	Color	Hard or Soft	Top	Bottom	Oil, Gas or Water	Depth Found	Remarks
Keokuk Sand	White	Hard	1905	1992	Sh. Oil Water	1950'	
Slate Linn	"	Medium	1992	2028		1980'	
Red Rock	Red	"	2028	2045			
Slate Linn	White	"	2045	2073			
Little Linn	"	Hard	2073	2085			
Pencil Cove	Black	Soft	2085	2089			
Big Linn	White	Hard	2089	2155			
Big Injun Sand	"	"	2155	2306	Gas	2246-51'	
Slate	"	Soft	2306	2309'			
Total Depth				2309'			

Date June 24, 1941.

Date

PITTSBURGH & WEST VA GAS COMPANY.

APPROVED

*J. S. [Signature]*

194

Owner

By

(Title)