


Latitude 39° 25'

Longitude 80° 25'

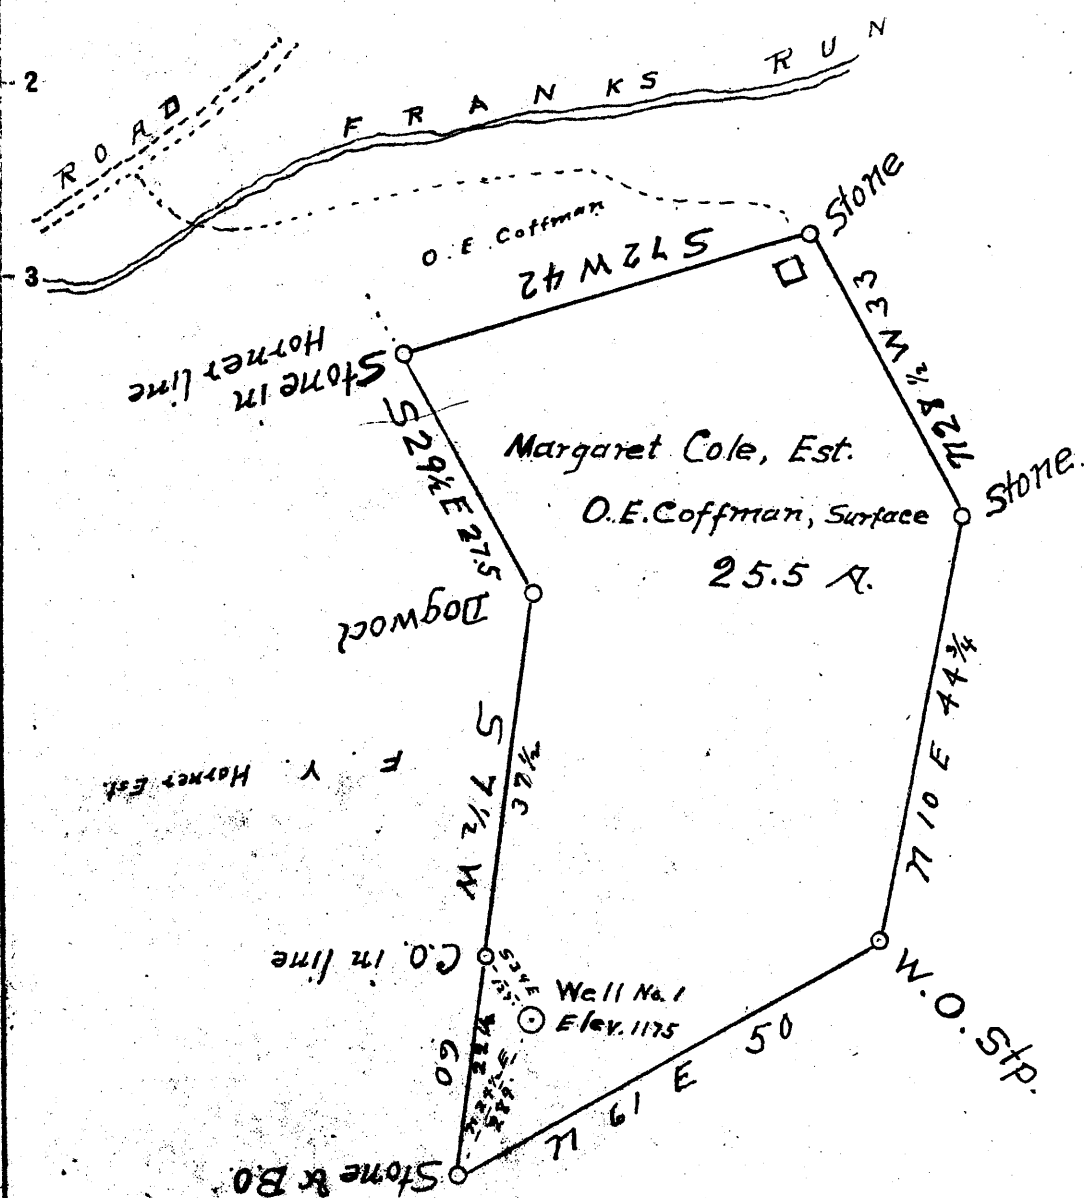

S 50.0
W 04.2

New Location
 Drill Deeper
 Abandonment

Company Wurtz Bros.
 Address West Union, W. Va.
 Farm Margaret Cole Est.
 Tract one Acres 25.5 Lease No. _____
 Well (Farm) No. 1 Serial No. _____
 Elevation (Spirit Level) 1175
 Quadrangle Centerpoint
 County Doddridge District McClellan
 Engineer J. M. Martin,
 Engineer's Registration No. 84
 File No. _____ Drawing No. _____
 Date Sept. 8, 1942 Scale 20 P = 1"

STATE OF WEST VIRGINIA
 DEPARTMENT OF MINES
 OIL AND GAS DIVISION
 CHARLESTON

WELL LOCATION MAP
 FILE NO. DOD-419-A

+ Denotes location of well on United States Topographic Maps, scale 1 to 62,500, latitude and longitude lines being represented by border lines as shown.

- Denotes one inch spaces on border line of original tracing.

STATE OF WEST VIRGINIA
DEPARTMENT OF MINES
OIL AND GAS DIVISION

332

WELL RECORD

Permit No. 419-A


Oil or Gas Well
(KIND)

Company Turtz Bros Inc.
Address Ashley, W. Va.
Farm Margaret Cole Acres 25.15
Location (waters) Franks Run
Well No. 1 Elev. 1175
District McClellan County Doddridge
The surface of tract is owned in fee by Ora Jefferson
Address Center Point
Mineral rights are owned by Margaret Cole Heirs
Address _____
Drilling commenced 1902
Drilling completed 1902
Date Shot _____ From _____ To _____
With _____
Open Flow _____ /10ths Water in _____ Inch
_____ /10ths Merc. in _____ Inch
Volume _____ Cu. Ft.
Rock Pressure _____ lbs _____ hrs.
Oil _____ bbls., 1st 24 hrs.
Fresh water _____ feet _____ feet
Salt water _____ feet _____ feet

Casing and Tubing	Used in Drilling	Left in Well	Packers
Size			Kind of Packer
16			
13			
10			Size of
8 1/4			
6 1/2	2015	2015	Depth set
5 3/16			
3			Perf. top
2	2200	2200	Perf. bottom
Liners Used			Perf. top
			Perf. bottom

CASING CEMENTED _____ SIZE _____ No. Ft. _____ Date _____
COAL WAS ENCOUNTERED AT _____ FEET _____ INCHES
_____ FEET _____ INCHES _____ FEET _____ INCHES
_____ FEET _____ INCHES _____ FEET _____ INCHES

Formation	Color	Hard or Soft	Top	Bottom	Oil, Gas or Water	Depth Found	Remarks
Pittsburgh Coal			860	864			
Little Dunkard			1125	1128			
Big Dunkard			1308	1312			
1st Salt			1515	1523			
2nd Salt			1620	1635			
3rd Salt			1700	1710			
Little Lime			1980	1992			
Big Lime			2005	2066			
Big Injun			2206	2245			
Bottom				2250			

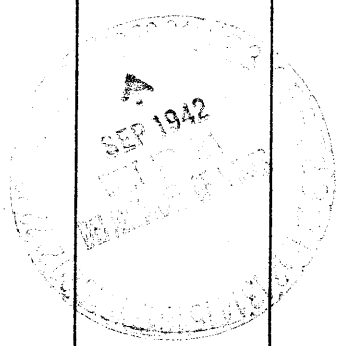

SEP 1942