


Latitude 39° 20'

Longitude 80° 40'

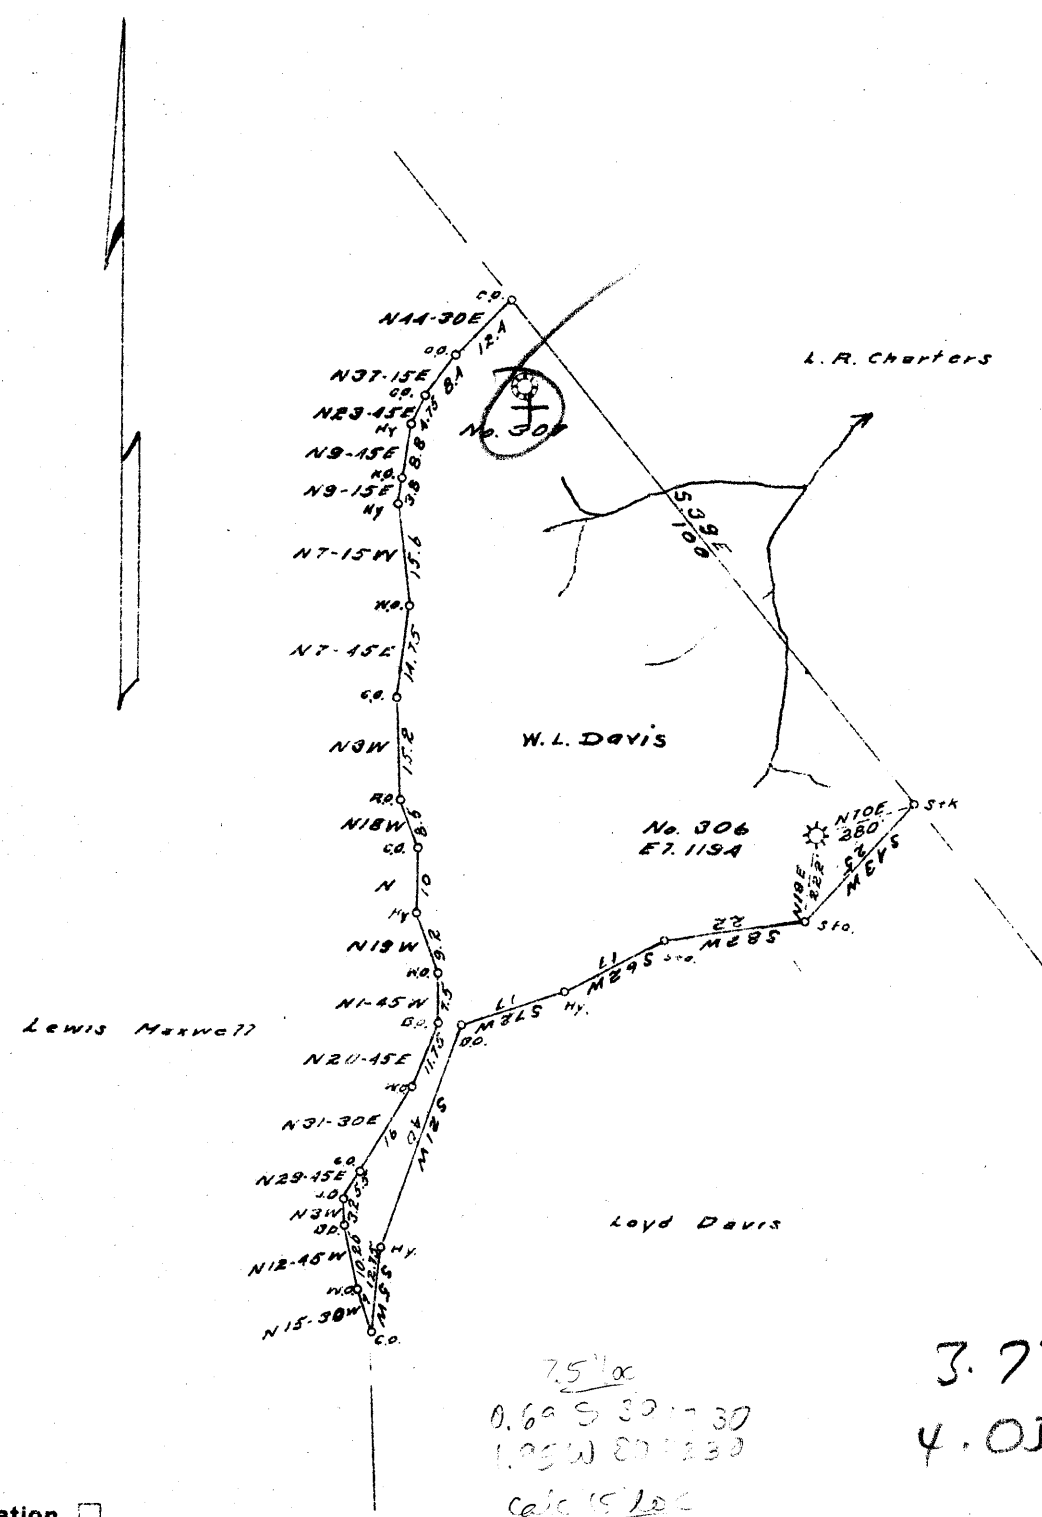

7.5' loc
 0.69 S 30° 17' 30"
 1.05 W 80° 12' 30"
 Calc 15' loc
 3.57 S
 4.18 W

3.77 S
 4.05 W

New Location
 Drill Deeper
 Abandonment

Company CARNEGIE NATURAL GAS
 Address PITTSBURGH Pa.
 Farm W. L. DAVIS
 Tract _____ Acres 34.5 Lease No. E-4625-18
 Well (Farm) No. 1 Serial No. E-306
 Elevation (Spirit Level) 1194'
 Quadrangle CENTERPOINT S.W.
 County DODDRIDGE District WEST UNION
 Engineer R. L. SWERNEY
 Engineer's Registration No. _____
 File No. _____ Drawing No. _____
 Date 3-11-12 Scale 1" = 300'

STATE OF WEST VIRGINIA
 DEPARTMENT OF MINES
 OIL AND GAS DIVISION
 CHARLESTON

WELL LOCATION MAP
 FILE NO. Dod. 423 A

+ Denotes location of well on United States Topographic Maps, scale 1 to 62,500, latitude and longitude lines being represented by border lines as shown.

- Denotes one inch spaces on border line of original tracing.