


Latitude 39 20'

Longitude 80 50'

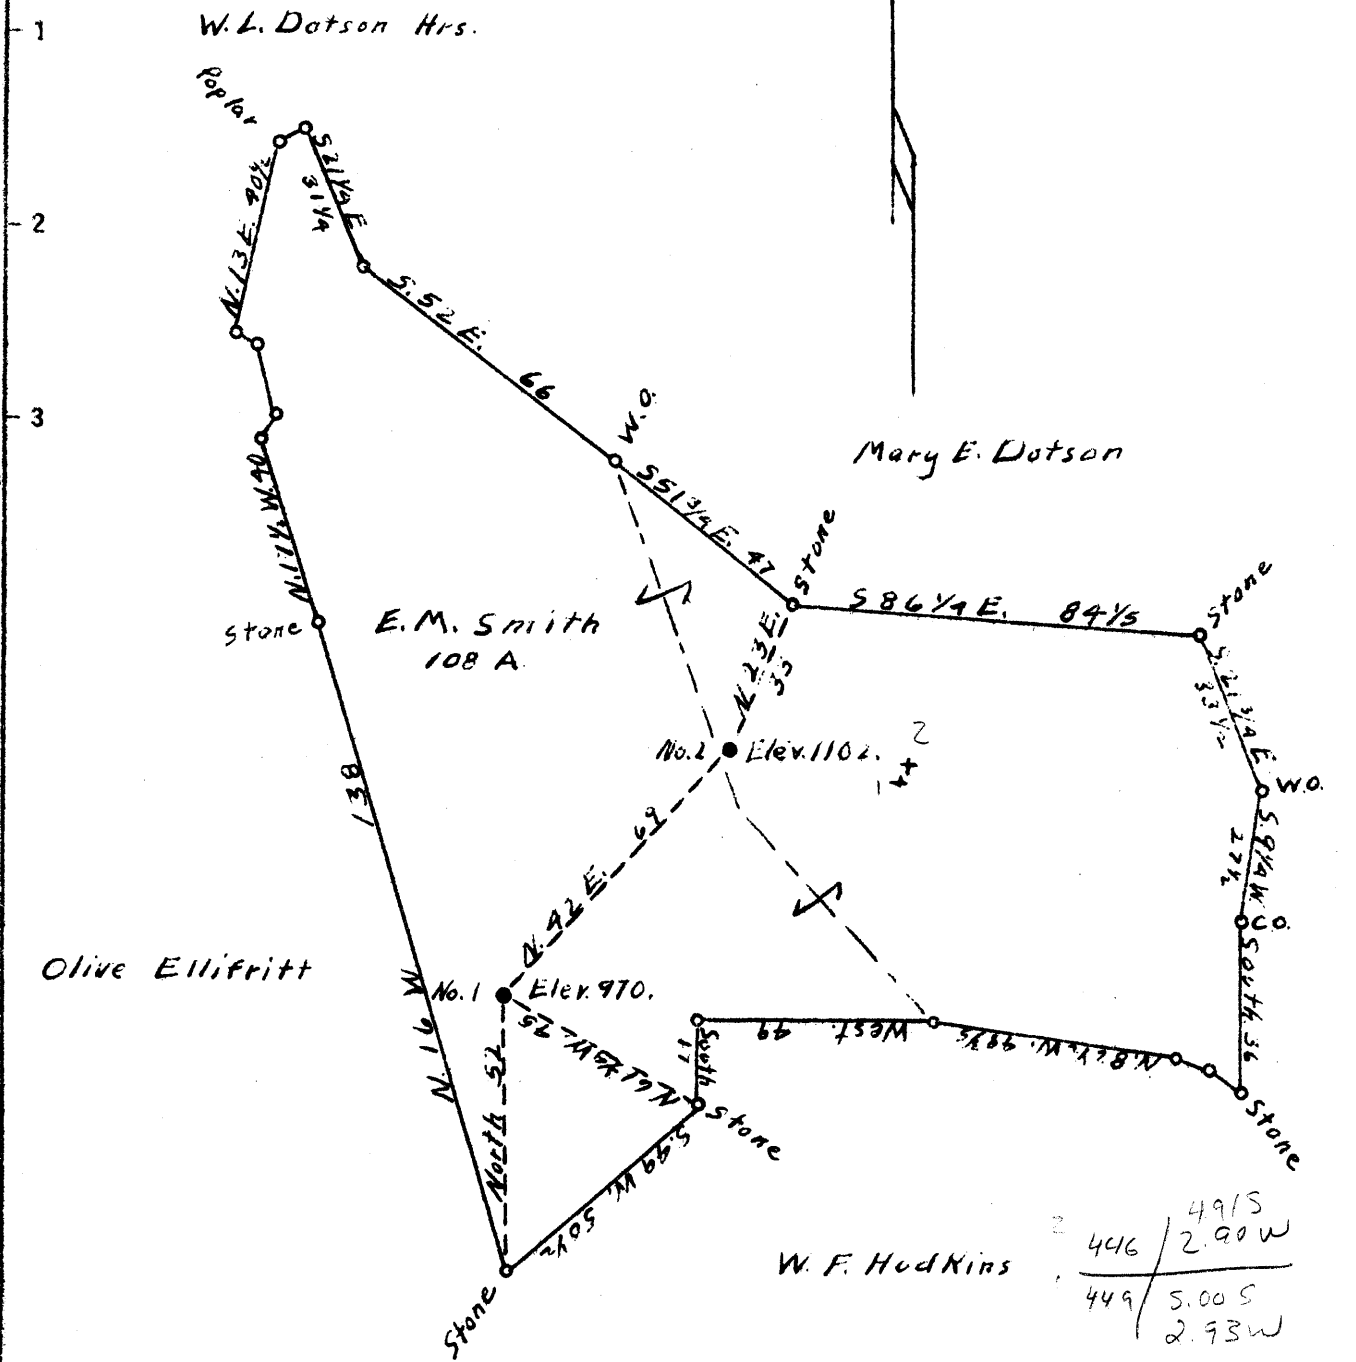

New Location
 Drill Deeper
 Abandonment

PLUGGED BY JRI-STATE PIPE CO

Company Reno Oil Co.

STATE OF WEST VIRGINIA