


Latitude 39 25

Longitude 80 40

2.46 S
0.33 W

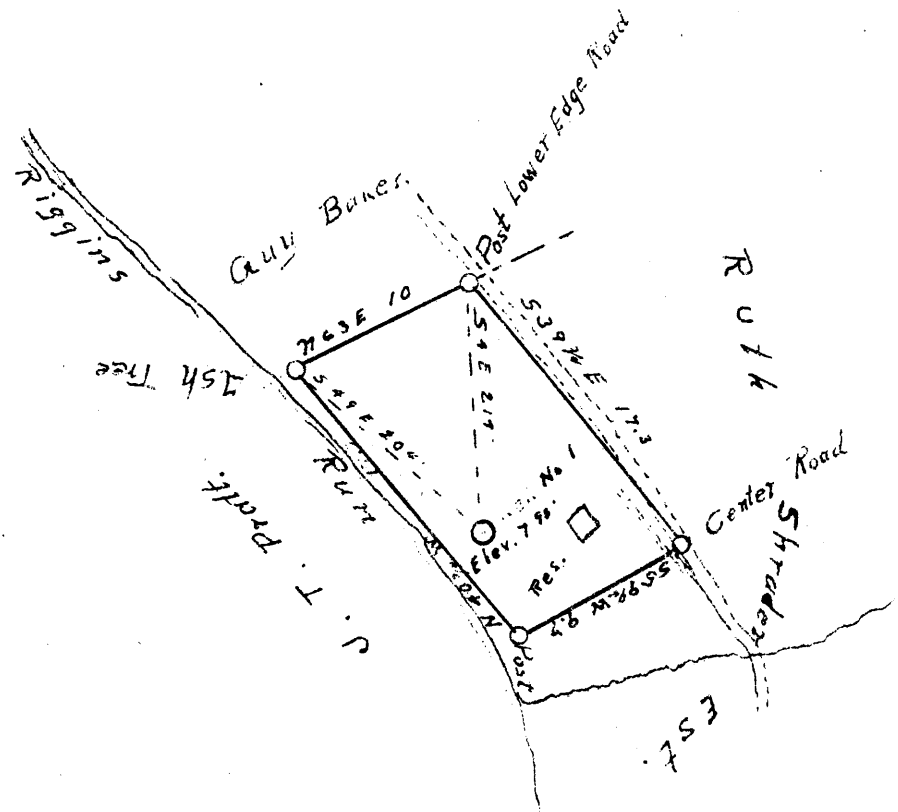

New Location
 Drill Deeper
 Abandonment

Company J. Moses Road
 Address Salem, W. Va.
 Farm Mary Shrader, Est.
 Tract One Acres 1A + 10/100 Lease No. _____
 Well (Farm) No. 1 Serial No. _____
 Elevation (Spirit Level) 790
 Quadrangle Centerpoint
 County Doddridge District McClellan
 Engineer J. M. Martin
 Engineer's Registration No. 84
 File No. _____ Drawing No. _____
 Date Nov. 25, 1943 Scale 10 P = 1 inch

STATE OF WEST VIRGINIA
 DEPARTMENT OF MINES
 OIL AND GAS DIVISION
 CHARLESTON

WELL LOCATION MAP

FILE NO. DOD-454-A

+ Denotes location of well on United States Topographic Maps, scale 1 to 62,500, latitude and longitude lines being represented by border lines as shown

- Denotes one inch spaces on border line of original tracing.

STATE OF WEST VIRGINIA
DEPARTMENT OF MINES
OIL AND GAS DIVISION

361

WELL RECORD

Ab
Permit No. 454-A


Oil or Gas Well
(Kind)

Company Raad Supply Company
Address Salem, W. Va.
Farm Mary Shrader Heirs Acres 1
Location (waters).....
Well No. 1 Elev. 790
District Mc Clellan County De Wading
The surface of tract is owned in fee by Shrader Heirs
Middlebourne, W. Va. Address.....
Mineral rights are owned by Shrader Heirs
Middlebourne, W. Va. Address.....
Drilling commenced.....
Drilling completed January 1, 1926
Date shot..... Depth of shot.....
Open Flow /10ths Water in..... Inch
/10ths Merc. in..... Inch
Volume..... Cu. Ft.
Rock Pressure..... lbs..... hrs.
Oil..... bbls., 1st 24 hrs.
Fresh water..... feet..... feet
Salt water..... feet..... feet

Casing and Tubing	Used in Drilling	Left in Well	Packers
Size			
16.....			Kind of Packer.....
13.....			
10.....			Size of.....
8 1/4.....			
6 5/8.....		1800	Depth set.....
5 3/16.....		1820	
3.....			Perf. top.....
2" Tbg.		1956	Perf. bottom.....
Liners Used.....			Perf. top.....
			Perf. bottom.....

CASING CEMENTED..... SIZE..... No. Ft..... Date.....
COAL WAS ENCOUNTERED AT..... FEET..... INCHES
..... FEET..... INCHES..... FEET..... INCHES
..... FEET..... INCHES..... FEET..... INCHES

Formation	Color	Hard or Soft	Top	Bottom	Oil, Gas or Water	Depth Found	Remarks
Pittsburgh	Coal		489	493			
Big Dunkard			995	1005			
Gas Sand			1075	1160			
Maxon Sand			1615	1651			
Little Lime			1745	1758			
Pencil Cave			1758	1775			
Big Lime			1800	1843			
Big Injun			1843	1956			
					Gas	1915-20	
					Oil	1937-42	
					Oil	1950	
Total Depth			1956				

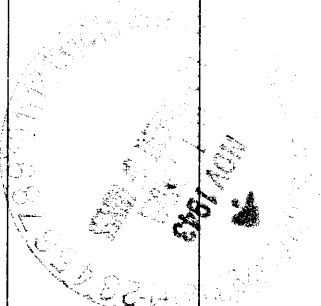

(Over)

MAR 30 1944

Formation	Color	Hard or Soft	Top	Bottom	Oil, Gas or Water	Depth Found	Remarks

Date....., 19.....

APPROVED *J.M. Paul*....., Owner

By *James*..... (Title)