

New Location
 Well Deeper
 Abandonment

FIELD BOOK 752 P20 MAP 59 811W6

Company HOPE NATURAL GAS CO.
 Address CLARKSBURG, W. VA.
 Farm E.B. JONES
 Tract 1 Acres 105 Lease No. 10398
 Well (Farm) No. 1 Serial No. 1500
 Elevation (Spirit Level) 870
 Quadrangle CENTERPOINT SE SW
 County DODDRIDGE District WEST UNION
 Engineer W.M. Bowers
 Engineer's Registration No. 900
 File No. _____ Drawing No. _____
 Date MAR. 7, 1944 Scale 1" = 30 Poles

STATE OF WEST VIRGINIA
 DEPARTMENT OF MINES
 OIL AND GAS DIVISION
 CHARLESTON

WELL LOCATION MAP
 FILE NO. Dod-458-A
 Well 017 92588

+ Denotes location of well on United States Topographic Maps, scale 1 to 62,500, latitude and longitude lines being represented by border lines as shown.

- Denotes one inch spaces on border line of original tracing.

72588 on CN6 maps



STATE OF WEST VIRGINIA
DEPARTMENT OF MINES
OIL AND GAS DIVISION

359

Ab 4587A
Permit No.

WELL RECORD


Oil or Gas Well
(KIND)

Company Hope Natural Gas Company.
 Address 445 West Main St. Clarksburg, W. Va.
 Farm E.B. Jones. Acres 105
 Location (waters) (O)
 Well No. 1500 Elev. 870
 District West Union County Doddridge
 The surface of tract is owned in fee by.....
 Address.....
 Mineral rights are owned by.....
 Address.....
 Drilling commenced March 3, 1910
 Drilling completed April 9, 1910
 Date Shot..... From..... To.....
 With.....
 Open Flow /10ths Water in..... Inch
 /10ths Merc. in..... Inch
 Volume..... Cu. Ft.
 Rock Pressure..... lbs..... hrs.
 Oil..... bbls., 1st 24 hrs.
 Fresh water..... feet..... feet
 Salt water 970 feet..... feet

Casing and Tubing	Used in Drilling	Left in Well	Packers
Size			
16			Kind of Packer.....
13			
10	190	190	Size of.....
8 1/4	995	995	
6 3/4	1546	1546	Depth set.....
5 3/16			
3			Perf. top.....
2			Perf. bottom.....
Liners Used.....			Perf. top.....
			Perf. bottom.....

~~Not cemented~~
 CASING CEMENTED..... SIZE..... No. Ft..... Date.....
 COAL WAS ENCOUNTERED AT 210 FEET 48 INCHES
 FEET..... INCHES..... FEET..... INCHES
 FEET..... INCHES..... FEET..... INCHES

Formation	Color	Hard or Soft	Top	Bottom	Oil, Gas or Water	Depth Found	Remarks
Pittsburgh Coal			210	214			
Little Dunkard			650	680			
Big Dunkard			710	740			
Gas Sand			855	930			
First Salt			965	985	water	970	
Second Salt			1040	1170	gas	1135-1148	
Maxon			1450	1470			
Pencil Cave			1495	1500			
Big Lime			1540	1620			
Big Injun			1620	1700	gas	1650-1693	
Squaw			1703	1723			
Total depth				1731			

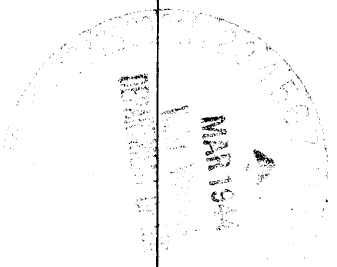

Formation	Color	Hard or Soft	Top	Bottom	Oil, Gas or Water	Depth Found	Remarks

Date March 6, 1944., 194

APPROVED Hope Natural Gas Company., Owner

By [Signature] Gen. Sup't
(Title)



STATE OF WEST VIRGINIA
DEPARTMENT OF MINES
OIL AND GAS DIVISION

017 458A

WELL RECORD

Permit No. _____ Oil or Gas Well _____ (KIND)

Company **(W. D. Gribble) HOPE**
Address _____
Farm **E. B. Jones** Acres **105**
Location (waters) **Buckeye Fork**
Well No. **1500** Elev. _____
District **West Union** County **Doddridge**

Casing and Tubing	Used in Drilling	Left in Well	Packers
Size			
16			Kind of Packer
13			
10	190	190	Size of
8 1/4	1002	995-10	
6 3/4	1546	1546	Depth set
5 3/16			
3			Perf. top
2	1739	None	Perf. bottom
Liners Used			Perf. top
			Perf. bottom

The surface of tract is owned in fee by _____
Address _____
Mineral rights are owned by _____
Address _____

Drilling commenced **Feb. 9, 1910**
Drilling completed **April 9, 1910**
Date Shot _____ From _____ To _____
With _____

Open Flow _____ /10ths Water in _____ Inch
_____ /10ths Me.c. in _____ Inch
Volume **787 M** Cu. Ft.
Rock Pressure **650** lbs. hrs.
Oil _____ bbls., 1st 24 hrs.
Fresh water _____ feet _____ feet
Salt water _____ feet **1135** feet

CASING CEMENTED _____ SIZE _____ No. Ft. _____ Date _____
COAL WAS ENCOUNTERED AT _____ FEET _____ INCHES
_____ FEET _____ INCHES FEET _____ INCHES
_____ FEET _____ INCHES FEET _____ INCHES

Formation	Color	Hard or Soft	Top	Bottom	Oil, Gas or Water	Depth Found	Remarks
Pgh. Coal			210	214			
Dunkard			650	740			
Salt			965	1170	Water Gas	970 1148	Salt Water
Maxon			1145	1470			
Injun			1620	1700	Gas	1693	
Gordon			2290	2298			
Fifth			2590	2595	Gas	2594	
Total Depth				2698			
Filled				1737	8-9-10		
Cleaned out				1795	2-28-41		
			Shot Injun Sand 1910 with 40 qts. Shot Fifth Sand 1910 with 20 qts. Shot Injun Sand 1941 with 80 qts. tamped				

JAN 21 1910

(Over)