

New Location
Drill Dreeper
Abandonment **x**

Company P. and M. Oil Co.
 Address West Union, W. Va.
 Farm C. L. Ford
 Tract 2 Acres 57.0 Lease No. _____
 Well (Farm) No. 1 Serial No. _____
 Elevation (Spirit Level) 1310
 Quadrangle Centerpoint
 County Putnam District New Milton
 Engineer J. M. Martin
 Engineer's Registration No. 84
 File No. _____ Drawing No. _____
 Date Aug 10 1944 Scale 40 Poles = 1 inch

STATE OF WEST VIRGINIA
DEPARTMENT OF MINES
OIL AND GAS DIVISION
CHARLESTON


WELL LOCATION MAP
FILE NO. DOD-470-A
was 017 73578

+ Denotes location of well on United States Topographic Maps, scale 1 to 62,500, latitude and longitude lines being represented by border lines as shown.
- Denotes one inch spaces on border line of original tracings.



STATE OF WEST VIRGINIA
DEPARTMENT OF MINES
OIL AND GAS DIVISION

WELL RECORD

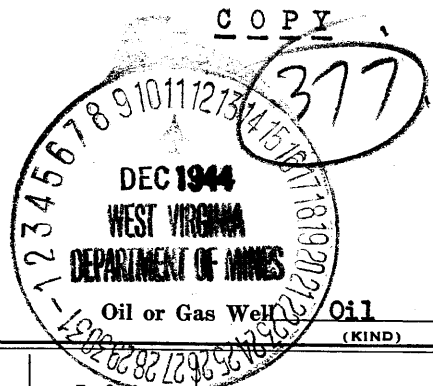

Permit No. DOD-470-A

Company P. & M. Oil and Gas Company
Address West Union, West Virginia
Farm C. L. Ford Acres 57.5
Location (waters) Sugar Camp
Well No. 1 Elev. 1310
District New Milton County Doddridge
The surface of tract is owned in fee by R. E. Kelley
Address Blandville, W. Va.

Mineral rights are owned by _____
Address _____

Drilling commenced May 11, 1926

Drilling completed June 26, 1926

Date Shot _____ From _____ To _____

With _____

Open Flow _____ /10ths Water in _____ Inch

_____ /10ths Merc. in _____ Inch

Volume _____ Cu. Ft.

Rock Pressure _____ lbs. _____ hrs.

Oil _____ bbls., 1st 24 hrs.

Fresh water _____ feet _____ feet

Salt water _____ feet _____ feet

Casing and Tubing	Used in Drilling	Left in Well	Packers
Size			
16			Kind of Packer
13			
10	395	None	Size of
8 1/4	1425	1425	
6 5/8	2250	2250	Depth set
5 3/16			
3			Perf. top
2			Perf. bottom
Liners Used			Perf. top
			Perf. bottom

CASING CEMENTED _____ SIZE _____ No. Ft. _____ Date _____

COAL WAS ENCOUNTERED AT 898 FEET _____ INCHES

_____ FEET _____ INCHES _____ FEET _____ INCHES

_____ FEET _____ INCHES _____ FEET _____ INCHES

Formation	Color	Hard or Soft	Top	Bottom	Oil, Gas or Water	Depth Found	Remarks
Pittsburgh Coal			898	903			
Little Dunkard			1290	1300			
Big Dunkard			1430	1485			
1st Salt Sand			1655	1705			
2d Salt Sand			1740	1872			
3d Salt Sand			1975	2030			
Maxon Shells			2084	2099			
Little Lime			2220	2232			
Pink Rock			2232	2236			
Pencil Cave			2236	2238			
Big Lime			2238	2283			
Big Injun Sand			2283	2381			
Oil and Gas			2288	2298			
Total Depth			2412				

