

3385  
0.19W

COAL OWNED BY VIRGINIA TETRICK

NEW LOCATION

DRILL DEEPER

ABANDONMENT

15' loc  
 0.535 32.780  
 2415  
 0.24W


COMPANY THE MANUFACTURERS LIGHT AND HEAT CO  
 ADDRESS 800 UNION TRUST BLD'G. PITTSBURGH PA.  
 TOWN C.L. FROM NOW FRED TATE  
 TRACT ACRES 42 LEASE NO 2789  
 WELL (FARM) NO SERIAL NO 1398  
 ELEVATION (SPIND LEVEL) 918'  
 QUADRANGLE CENTERPOINT  
 TOWNSHIP DODDRIDGE DISTRICT GRANT  
 ENGINEER  
 DRAWING NO. Y-11-68  
 DATE SEP 15 1944 SCALE 1" = 500'

STATE OF WEST VIRGINIA  
 DEPARTMENT OF MINES  
 OIL AND GAS DIVISION  
 CHARLESTON  
 WELL LOCATION MAP  
 FILE NO DOD-472-A

BEARINGS TAKEN AND PLATS BY UNITED STATES TOPOGRAPHIC PARTY 1870 TO 1890S. LATITUDE AND LONGITUDE LINES BEING REPRESENTED BY DOTTED LINES AS SHOWN



STATE OF WEST VIRGINIA  
DEPARTMENT OF MINES  
OIL AND GAS DIVISION

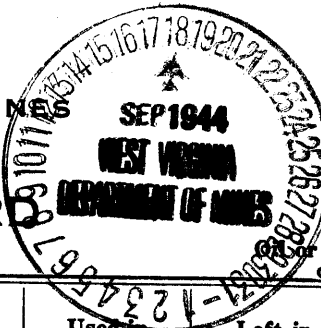

387

Ab 472-A  
Permit No. Drilled in 1910

WELL RECORD


Gas Well (Kind)

Company The Manufacturers Light & Heat Company  
 Address 800 Union Trust Building, Pittsburgh, Pa  
 Farm C. L. Frym Acres 42  
 Location (waters) \_\_\_\_\_  
 Well No. 1 - 1398 Elev. 918  
 District Grant County Doddridge  
 The surface of tract is owned in fee by M. E. Ross  
200 S Franklin St., Address Richwood, Ohio  
 Mineral rights are owned by The Mfrs Light & Heat Co.  
800 Union Trust Bldg. Address Pittsburgh, Pa.  
 Drilling commenced 4/13/10  
 Drilling completed 5/12/10  
 Date Shot \_\_\_\_\_ From \_\_\_\_\_ To \_\_\_\_\_  
 With \_\_\_\_\_  
 Open Flow \_\_\_\_\_ /10ths Water in \_\_\_\_\_ Inch  
 \_\_\_\_\_ /10ths Merc. in \_\_\_\_\_ Inch  
 Volume \_\_\_\_\_ Cu. Ft.  
 Rock Pressure 430# lbs. \_\_\_\_\_ hrs.  
 Oil \_\_\_\_\_ bbls., 1st 24 hrs.  
 Fresh water \_\_\_\_\_ feet \_\_\_\_\_ feet  
 Salt water \_\_\_\_\_ feet \_\_\_\_\_ feet

Casing and Tubing	Used in Drilling	Left in Well	Packers
Size			
16			Kind of Packer
13			
10	915'	-	Size of
8 1/4	1112'	-	4 x 6 1/8
6 1/2	1758'	1758'	Depth set
5 3/16			1768'
4 1/2	1915'	1915'	Perf. top
2			Perf. bottom
Liners Used			Perf. top
			Perf. bottom

CASING CEMENTED \_\_\_\_\_ SIZE \_\_\_\_\_ No. Ft. \_\_\_\_\_ Da \_\_\_\_\_  
 COAL WAS ENCOUNTERED AT 120 FEET 36 INCHES  
394 FEET 84 INCHES FEET INCHES  
 FEET INCHES FEET INCHES

Formation	Color	Hard or Soft	Top	Bottom	Oil, Gas or Water	Depth Found	Remarks
Native Coal			120	123			
Pittsburgh Coal			394	401			
Big Dunkard Sand			905	955			
Gas Sand			1035	1075			
Salt Sand			1085	1370			
Little Lime			1647	1664			
Pencil Cave			1664	1680			
Big Lime			1680	1770			
Big Injun			1770	1880			
Gas Sand			1775	1795			
Squaw Sand			1800	1811			
Total depth				2015			

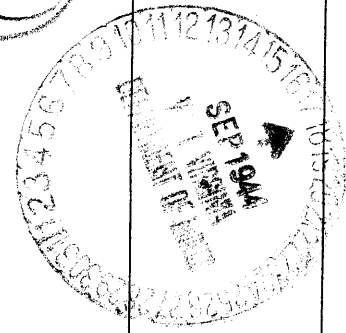

Formation	Color	Hard or Soft	Top	Bottom	Oil, Gas or Water	Depth Found	Remarks

Date September 16th, 194 4

APPROVED THE MANUFACTURERS LIGHT & HEAT COMPANY, Owner

By Harry H. Fowler  
 Lead Department (Title) Office Manager