

New Location   
 Drill Deeper  - 7027  
 Abandonment

Company HOPE NATURAL GAS CO.  
 Address CLARKSBURG, W. VA.  
 Farm ISRAEL WILLIAMS  
 Tract 1 Acres 128 Lease No. \_\_\_\_\_  
 Well (Farm) No. 3 Serial No. 7027  
 Elevation (Spirit Level) 949  
 Quadrangle CENTERPOINT  
 County DODDRIDGE District GRANT  
 Engineer W.M. Bowers  
 Engineer's Registration No. 900  
 File No. \_\_\_\_\_ Drawing No. \_\_\_\_\_  
 Date JAN. 3, 1941 Scale 1" = 400'

STATE OF WEST VIRGINIA  
 DEPARTMENT OF MINES  
 OIL AND GAS DIVISION  
 CHARLESTON

**WELL LOCATION MAP**  
 FILE NO. DOD-112-7027  
DOD-476-A-Well 7025

+ Denotes location of well on United States Topographic Maps, scale 1 to 62,500, latitude and longitude lines being represented by border lines as shown.

- Denotes one inch spaces on border line of original tracing.



STATE OF WEST VIRGINIA  
DEPARTMENT OF MINES  
OIL AND GAS DIVISION

385

WELL RECORD

Permit No. 4767A


Oil or Gas Well (KIND)

Company Hope Natural Gas Company.  
 Address 445 West Main St. Clarksburg, W. Va.  
 Farm I. Williams Acres 100  
 Location (waters) \_\_\_\_\_  
 Well No. 7025 Elev. 897  
 District Grant County Doddridge  
 The surface of tract is owned in fee by \_\_\_\_\_  
 Address \_\_\_\_\_  
 Mineral rights are owned by \_\_\_\_\_  
 Address \_\_\_\_\_  
 Drilling commenced October 15, 1901  
 Drilling completed December 23, 1901  
 Date Shot \_\_\_\_\_ From \_\_\_\_\_ To \_\_\_\_\_  
 With Purchased  
 Open Flow \_\_\_\_\_ /10ths Water in \_\_\_\_\_ Inch  
 \_\_\_\_\_ /10ths Merc. in \_\_\_\_\_ Inch  
 Volume \_\_\_\_\_ Cu. Ft.  
 Rock Pressure \_\_\_\_\_ lbs. \_\_\_\_\_ hrs.  
 Oil \_\_\_\_\_ bbls., 1st 24 hrs.  
 Fresh water none recorded feet \_\_\_\_\_ feet  
 Salt water 1155 1360 feet \_\_\_\_\_ feet

Casing and Tubing	Used in Drilling	Left in Well	Packers
Size			
16			Kind of Packer
13			
10	<u>218</u>	<u>Pulled</u>	Size of
8 1/4	<u>1000</u>	<u>Puled</u>	
6 3/4	<u>1251</u>	<u>1251</u>	Depth set
5 3/16	<u>1805</u>	<u>1805</u>	
3	<u>1833</u>	<u>Pulled</u>	Perf. top
2			Perf. bottom
Liners Used			Perf. top
			Perf. bottom

CASING CEMENTED Not cemented SIZE \_\_\_\_\_ No. Ft. \_\_\_\_\_ Date \_\_\_\_\_  
 COAL WAS ENCOUNTERED AT 375 FEET 60 INCHES  
 \_\_\_\_\_ FEET \_\_\_\_\_ INCHES FEET \_\_\_\_\_ INCHES  
 \_\_\_\_\_ FEET \_\_\_\_\_ INCHES FEET \_\_\_\_\_ INCHES

Formation	Color	Hard or Soft	Top	Bottom	Oil, Gas or Water	Depth Found	Remarks
Pittsburgh	Coal		375	380			
	Red r ck		700	800			
	Lst. Cow Run		800	850			
	First Salt		1140	1290	water	1155	
	Big Lime		1750	1850	water	1360	
	Big Injun		1850	1950	gas	1924	
	Berea		2150				
	Gordon		2500	2533	gas	?	
	Fifth		2665	2668			
	<u>Total depth</u>			<u>2700</u>			
	Filled back to			2575			

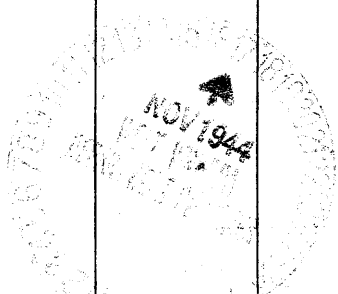

JAN 22 1945

