

New Location
 Drill Deeper
 Abandonment X 7043

Map Sh. 68 Sq. 5-17 W-9 F.B. 775 P. 849

Company	HOPE NATURAL GAS CO.
Address	CLARKSBURG, W. VA.
Farm	W. BRENT MAXWELL
Tract	Acres 2400 Lease No. 41998
Well (Farm) No.	Serial No. AS SHOWN
Elevation (Spirit Level)	AS SHOWN
Quadrangle	HOLBROOK
County	DODDRIDGE District SOUTHWEST
Engineer	W. M. Bowers
Engineer's Registration No.	900
File No.	Drawing No.
Date	6-5-45 Scale 1" = 40P

STATE OF WEST VIRGINIA
 DEPARTMENT OF MINES
 OIL AND GAS DIVISION
 CHARLESTON


WELL LOCATION MAP
 FILE NO. DOD-492-A

+ Denotes location of well on United States Topographic Maps, scale 1 to 62,500, latitude and longitude lines being represented by border lines as shown.

- Denotes one inch spaces on border line of original tracing.



STATE OF WEST VIRGINIA
DEPARTMENT OF MINES
OIL AND GAS DIVISION

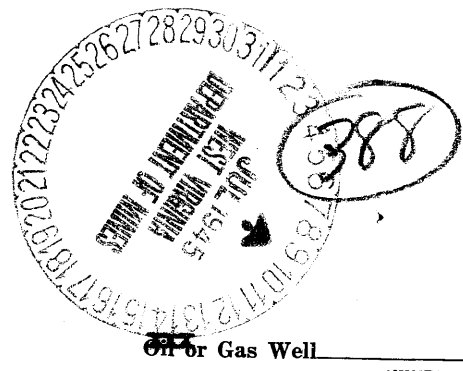

WELL RECORD

Permit No. Y87-A

Oil or Gas Well (KIND)

Company Hope Natural Gas Company
 Address 445 W. Main St. Clarksburg, W. Va.
 Farm W. B. Maxwell Acres 2400
 Location (waters) _____
 Well No. 7043 Elev. 1274
 District Southwest County Doddridge
 The surface of tract is owned in fee by _____
 Address _____
 Mineral rights are owned by _____
 Address _____
 Drilling commenced December 27, 1921
 Drilling completed February 21, 1922
 Date Shot _____ From _____ To _____
 With _____
 Open Flow _____ /10ths Water in _____ Inch
 _____ /10ths Merc. in _____ Inch
 Volume _____ Cu. Ft.
 Rock Pressure _____ lbs. _____ hrs.
 Oil _____ bbls., 1st 24 hrs.
 Fresh water None reported feet _____ feet
 Salt water _____ feet _____ feet

Casing and Tubing	Used in Drilling	Left in Well	Packers
Size			Kind of Packer
16			
13			
10	522	Pulled	Size of
8 1/4	1125	Pulled	
6 5/8	1895	1895	Depth set
5 3/16			
3			Perf. top
2			Perf. bottom
Liners Used			Perf. top
			Perf. bottom

CASING CEMENTED _____ SIZE _____ No. Ft. _____ Date _____
None reported
 COAL WAS ENCOUNTERED AT _____ FEET _____ INCHES
 _____ FEET _____ INCHES FEET _____ INCHES
 _____ FEET _____ INCHES FEET _____ INCHES

Formation	Color	Hard or Soft	Top	Bottom	Oil, Gas or Water	Depth Found	Remarks
1st Cow Run			805	870			
First Salt			1350	1480 (1410)			
Second Salt			1560	1660			
Big Lime			1888	1959			
Injun			1959	2025	Gas	1970	
Berea			2165	2295			
Thirty Foot			2609	2614	Gas	2610	
Total depth				2632			

