


+ 0.86 S
4.44 W

JOSHUA DAVISSON

EDITH TRADER 41A

A. J. DYE

W. J. SWIGER

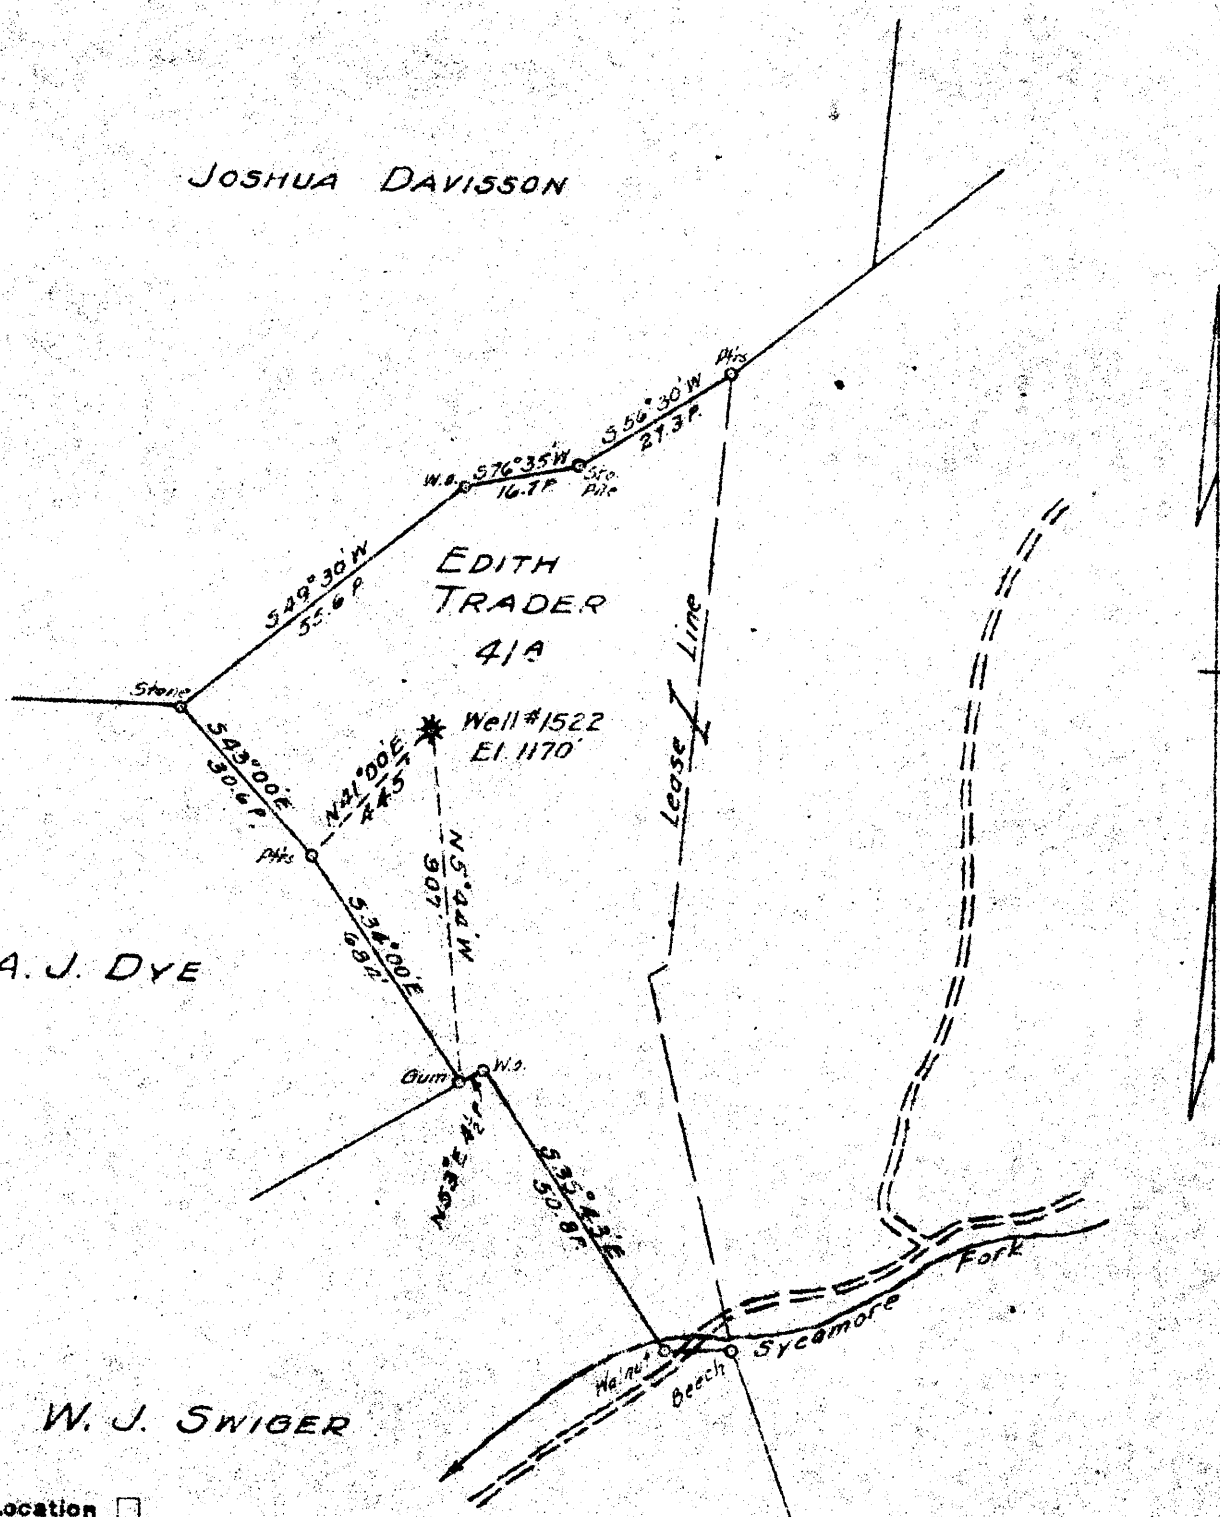

- New Location
- Drill Deeper
- Abandonment

Map Sh. 45 Sq. 5-4 E-2 F.B. 545 P. 16-17

Company HOPE NATURAL GAS CO.
 Address CLARKSBURG, W. VA.
 Farm EDITH TRADER
 Tract _____ Acres 41 Lease No. 632
 Well (Farm) No. _____ Serial No. 1522
 Elevation (Spirit Level) 1170'
 Quadrangle CENTERPOINT
 County DODDRIDGE District M'CLELLAN
 Engineer W. M. Bowers
 Engineer's Registration No. 900
 File No. _____ Drawing No. _____
 Date 6-19-25 Scale 1" = 300'

STATE OF WEST VIRGINIA
DEPARTMENT OF MINES
OIL AND GAS DIVISION
CHARLESTON

WELL LOCATION MAP
FILE NO. DOD-490-A

- + Denotes location of well on United States Topographic Maps, scale 1 to 62,500, latitude and longitude lines being represented by border lines as shown.
- Denotes one inch spaces on border line of original tracing.



STATE OF WEST VIRGINIA
DEPARTMENT OF MINES
OIL AND GAS DIVISION

397

WELL RECORD

Permit No. 440 A

~~Oil~~ or Gas Well (KIND)

Company Hope Natural Gas Company.
 Address 445 West Main St. Clarksburg, W. Va.
 Farm Edith Trader Acres 41
 Location (waters) _____
 Well No. 1522 Elev. 1170
 District McClellan County Doddridge
 The surface of tract is owned in fee by _____
 Address _____
 Mineral rights are owned by _____
 Address _____
 Drilling commenced December 15, 1909
 Drilling completed January 26, 1910
 Date Shot _____ From _____ To _____
 With _____
 Open Flow _____ /10ths Water in _____ Inch
 _____ /10ths Merc. in _____ Inch
 Volume _____ Cu. Ft.
 Rock Pressure _____ lbs. _____ hrs.
 Oil _____ bbls., 1st 24 hrs.
 Fresh water _____ feet _____ feet
 Salt water 1500 feet _____ feet

Casing and Tubing	Used in Drilling	Left in Well	Packers
Size			
16			Kind of Packer
13			
10	334	334	Size of
8 1/4	1300	1300	
6 5/8	2089	2089	Depth set
5 3/16			
3			Perf. top
2	2935	2935	Perf. bottom
Liners Used			Perf. top
			Perf. bottom

CASING CEMENTED Not cemented SIZE _____ No. Ft. _____ Date _____

COAL WAS ENCOUNTERED AT 788 FEET 36 INCHES
 _____ FEET _____ INCHES FEET _____ INCHES
 _____ FEET _____ INCHES FEET _____ INCHES

Formation	Color	Hard or Soft	Top	Bottom	Oil, Gas or Water	Depth Found	Remarks
Pittsburg Coal			788	791			
Big Dunkard			1295	1410			
Gas sand			1450	1510	water	1500	
First Salt			1520	1590			
Second Salt			1640	1800			
Maxon			1885	1910			
Little Lime	4		1975	1990			
Pencil cave			1990	2000			
Big Lime			2000	2095			
Big Injun			2095	2195	gas	2175	
Squaw			2220	2235			
Gantz			2375	2400			
Fifty foot			2575	2600			
Thirty Foot			2750	2795			
Gordon Stray			2841	2857	gas	2842	
Gordon			2891	2916			
Total depth				2935			

Formation	Color	Hard or Soft	Top	Bottom	Oil, Gas or Water	Depth Found	Remarks

Date June 26, 1945, 194

APPROVED Hope Natural Gas Company., Owater

By *[Signature]*
Ass't. to Gen. Sup't. (Title)

