


E.M. Smith

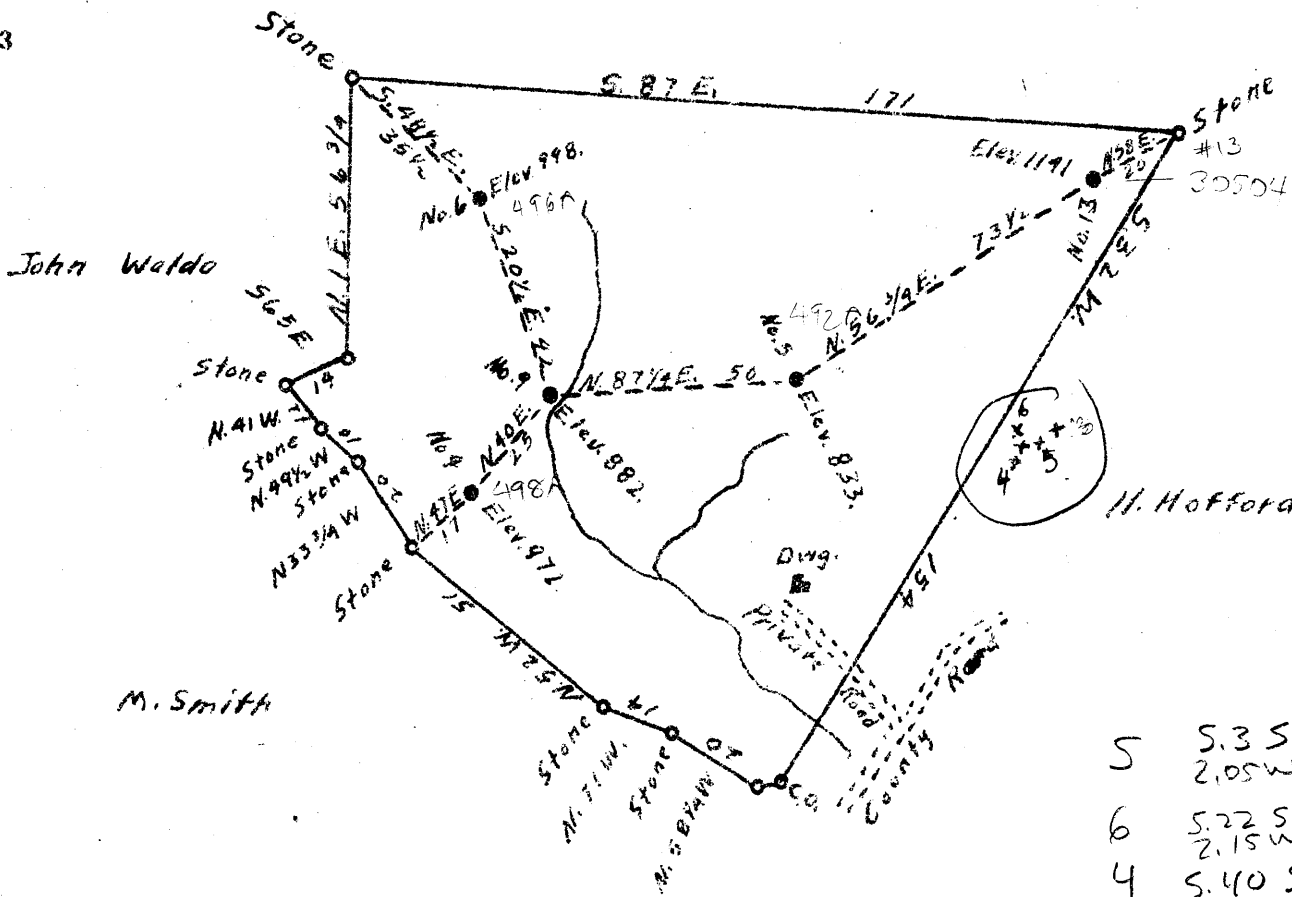

New Location
 Drill Deeper
 Abandonment

Company Beno Oil Co.
 Address Sistersville, W. Va.
 Farm W. F. Hudkins
 Tract _____ Acres 97A 13 1/4 Lease No. _____
 Well (Farm) No. 4-5-6-8-13 Serial No. _____
 Elevation (Salt Level) 972-833-998-882-1141
 Quadrangle West Union
 County Doddridge District Central
 Engineer A. K. Westfall
 Engineer's Registration No. 62 Surveyor, Putches County
 File No. _____ Drawing No. _____
 Date June 12, 1942 Scale 1" = 40' Poles

STATE OF WEST VIRGINIA
 DEPARTMENT OF MINES
 OIL AND GAS DIVISION
 CHARLESTON

WELL LOCATION MAP

FILE NO. DOD-492-A-#5
DOD-496-A-#6
DOD-498-A-#4

+ Denotes location of well on United States Topographic Maps, scale 1 to 62,500. latitude and longitude lines being represented by border lines as shown.

- Denotes one inch spaces on border line of original tracing.



COPY

394

STATE OF WEST VIRGINIA
DEPARTMENT OF MINES
OIL AND GAS DIVISION

WELL RECORD

Permit No. Dod -492 A

Oil or Gas Well Oil


Company Tri State Pipe Company
 Address Bellaire, Ohio
 Farm W.F. Hudkins Acres _____
 Location (waters) _____
 Well No. 5 Elev. 733
 District Central County Doddridge
 The surface of tract is owned in fee by _____
 Address _____
 Mineral rights are owned by _____
 Address _____
 Drilling commenced _____
 Drilling completed _____
 Date Shot _____ From _____ To _____
 With top of shot, 2125
 Open Flow _____ /10ths Water in _____ Inch
 _____ /10ths Merc. in _____ Inch
 Volume _____ Cu. Ft.
 Rock Pressure _____ lbs. _____ hrs.
 Oil _____ bbls., 1st 24 hrs.
 Fresh water _____ feet _____ feet
 Salt water _____ feet _____ feet

Casing and Tubing	Used in Drilling	Left in Well	Packers
Size			Kind of Packer
16			
13			
10		pulled	Size of
8 1/4		"	
6 5/8		1995	Depth set
5 3/16			
3			Perf. top
2		2163	Perf. bottom
Liners Used			Perf. top
			Perf. bottom

CASING CEMENTED _____ SIZE _____ No. Ft. _____ Date _____

COAL WAS ENCOUNTERED AT _____ FEET _____ INCHES
 _____ FEET _____ INCHES FEET _____ INCHES
 _____ FEET _____ INCHES FEET _____ INCHES

Formation	Color	Hard or Soft	Top	Bottom	Oil, Gas or Water	Depth Found	Remarks
Sand			315	350			
Sand			1310	1360			
Salt Sand			1760	1830			
Maxon Sand			1942	1960			
Little Lime			1969	1989			
Pencil Cave			1989	1995 --6	5/8"		
Big Lime			1995	2125			
Sand			2125				
Show oil at	2125-2130						
Total Depth	2163						
Top of shot	2125						

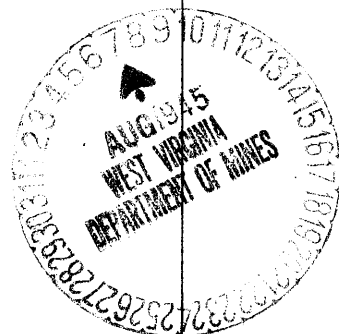

SEP 18 1945