


M

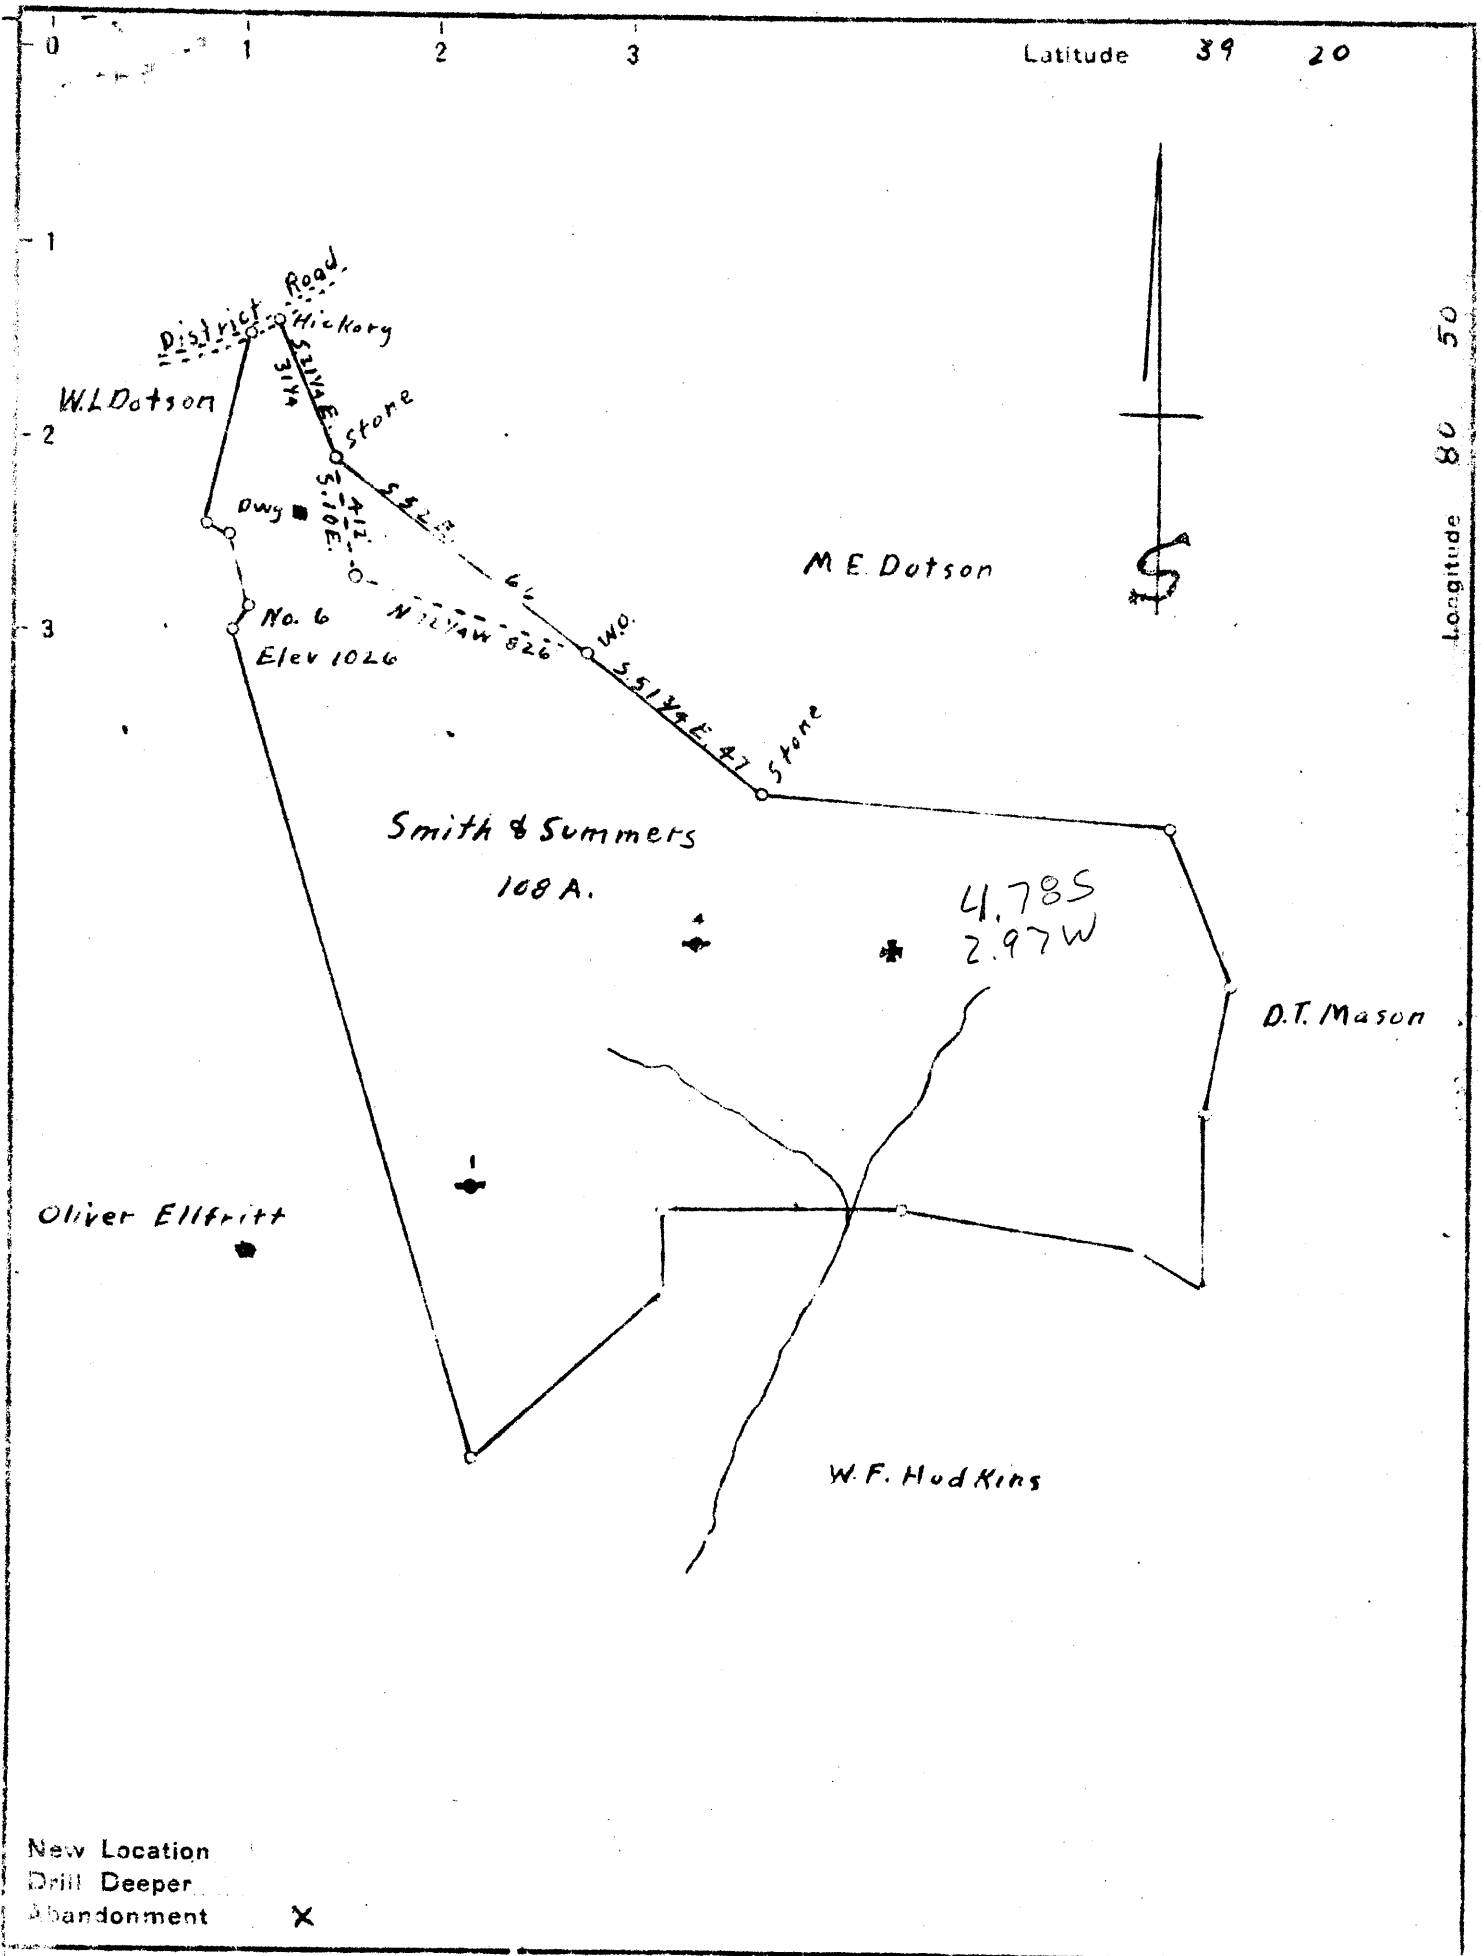

Company Tri State Pipe Co
 Address Bellaire Ohio
 Farm E.M. Smith & Summers
 Tract _____ Acres 108 Lease No. _____
 Well (Farm) No. 6 Serial No. _____
 Elevation (Spirit Level) 1026
 Quadrangle West Union
 County Doddridge District Central
 Engineer O.R. Westfall
 Engineer's Registration No. _____
 File No. _____ Drawing No. _____
 Date August 7, 1945 Scale 1" = 40 P.M.

STATE OF WEST VIRGINIA
 DEPARTMENT OF MINES
 OIL AND GAS DIVISION
 CHARLESTON

WELL LOCATION MAP
 FILE NO. DOD-494-A

+ Denotes location of well on United States Topographic Maps, scale 1 to 62,500, latitude and longitude lines being represented by border lines as shown.

- Denotes one inch spaces on border line of original tracing



STATE OF WEST VIRGINIA
DEPARTMENT OF MINES
OIL AND GAS DIVISION

396

Permit No. 494-A

WELL RECORD
COPY


Oil or Gas Well Oil

Company The Tri-State Pipe Company
Address Bellaire, Ohio
Farm Smith & Summers Acres 108
Location (waters) _____
Well No. 6 Elev. 1026
District Central County Doddridge
The surface of tract is owned in fee by _____
Address _____
Mineral rights are owned by _____
Address _____
Drilling commenced _____
Drilling completed _____
Date Shot top of shot From 2096' To _____
With _____
Open Flow /10ths Water in _____ Inch
/10ths Merc. in _____ Inch
Volume _____ Cu. Ft.
Rock Pressure _____ lbs. _____ hrs.
Oil _____ bbls., 1st 24 hrs.
Fresh water _____ feet _____ feet
Salt water _____ feet _____ feet

Casing and Tubing	Used in Drilling	Left in Well	Packers
Size			
16			Kind of Packer
13			
10		Pulled	Size of
8 1/4		"	
6 3/8		2041'	Depth set
5 3/16			
3			Perf. top
2			Perf. bottom
Liners Used			Perf. top
			Perf. bottom

CASING CEMENTED _____ SIZE _____ No. Ft. _____ Da _____
COAL WAS ENCOUNTERED AT _____ FEET _____ INCHES
_____ FEET _____ INCHES _____ FEET _____ INCHES
_____ FEET _____ INCHES _____ FEET _____ INCHES

Formation	Color	Hard or Soft	Top	Bottom	Oil, Gas or Water	Depth Found	Remarks
Hurry up Sand			720	730			
Little Dunkard			1200	1240			
Big Dunkard			1295	1350			
Stray Sand			1360	1375			
FIRST SALT SAND			1400 1600	1400 1645		1600-1645'	
Second Salt Sand			1770	1805			
Little Lime Sand			2010	2024			
Big Lime			2024	2035			
Big Injun			2034	2095			
Slate & Shells			2095	2140			
Total Depth			2140	2156			

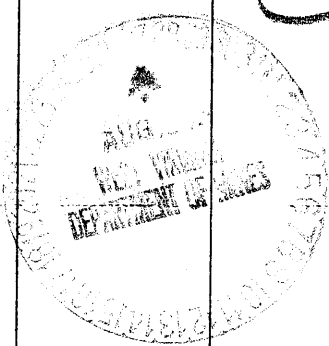

(Over)

SEP 18 1945