


+ 0.75 S
3.06 W

Scale, 1" = 800'

LONG. 80° 40'

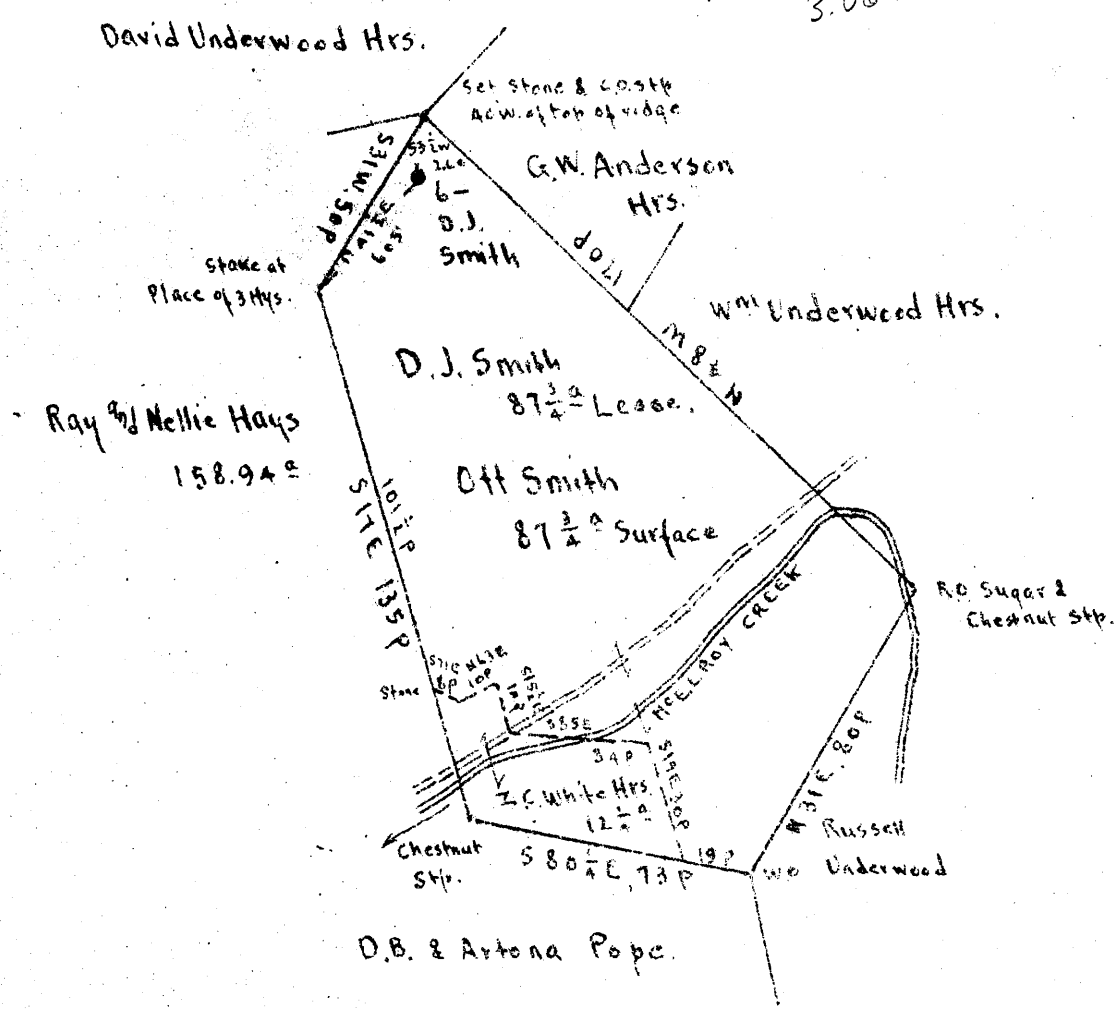

Surface: Ott Smith, West Union (Star Route) W.Va.
 Coal: Mrs. Blanche George and Miss Cilda L. Smith.
 Address Mrs. Blanche George
 216 Chicago St., Fairmont, W.Va.

- New Location
- Drill Deeper
- Abandonment

Map N 47 S 3 W 6

Company Interstate Pipe and Supply Co.
 Address Marietta Ohio.
 Farm D.J. Smith
 Tract _____ Acres 87 3/4 Lease No. _____
 Well (Farm) No. 6 Serial No. _____
 Elevation (Spirit Level) Floor 1165.80
 Ground 1161.95
 Quadrangle Centerpoint
 County Doddridge District McClellan
 Engineer E C Tabler
 Engineer's Registration No. _____
 File No. _____ Drawing No. _____
 Date Sept. 11th 1945 Scale 1" = 800'

STATE OF WEST VIRGINIA
 DEPARTMENT OF MINES
 OIL AND GAS DIVISION
 CHARLESTON

WELL LOCATION MAP
 FILE NO. DOD-507-A

+ Denotes location of well on United States Topographic Maps, scale 1 to 62,500, latitude and longitude lines being represented by border lines as shown.

- Denotes one inch spaces on border line of original tracing.



418

STATE OF WEST VIRGINIA
DEPARTMENT OF MINES
OIL AND GAS DIVISION

WELL RECORD

Permit No. 507-A

Oil or Gas Well Oil
(KIND)


Company The Interstate Pipe & Supply Company
 Address P. O. Box 611, Marietta, Ohio
 Farm D. J. Smith Acres 87 3/4
 Location (waters).....
 Well No. 6 Elev. 1162.9
 District McClellan County Doddridge
 The surface of tract is owned in fee by Ott Smith
 Address West Union, W.Va.
 Mineral rights are owned by Mrs. Blanche George and
Miss Cilda L. Smith Address Fairmont, W.Va.
 Drilling commenced.....
 Drilling completed April 22, 1895
 Date Shot 8/24/02 From 2291 To.....
 With.....

Casing and Tubing	Used in Drilling	Left in Well	Packers
Size			Kind of Packer
16. (1165.0) DE			
13.			Size of
10.	602	Doubtful	Depth set
8 1/4	1241	Doubtful	
6%	2230	2230	Perf. top
5 3/16	1743	1743	Perf. bottom
3.			Perf. top
2.			Perf. bottom
Liners Used			

Open Flow /10ths Water in..... Inch
 /10ths Merc. in..... Inch
 Volume..... Cu. Ft.
 Rock Pressure..... lbs..... hrs.
 Oil..... bbls., 1st 24 hrs.
 Fresh water..... feet..... feet
 Salt water..... feet..... feet

CASING CEMENTED..... SIZE..... No. Ft..... Date.....
 COAL WAS ENCOUNTERED AT 895 FEET 60 INCHES
 FEET..... INCHES..... FEET..... INCHES
 FEET..... INCHES..... FEET..... INCHES

Formation	Color	Hard or Soft	Top	Bottom	Oil, Gas or Water	Depth Found	Remarks
Pittsburgh Coal			895	900			
Salt Sand			1777	1827			
Big Injun Sand			2213				
Pay			2293				
Total Depth				2324			

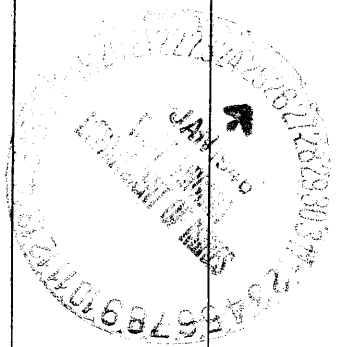

Formation	Color	Hard or Soft	Top	Bottom	Oil, Gas or Water	Depth Found	Remarks

Date January 23, 194 6

APPROVED THE INTERSTATE PIPE & SUPPLY COMPANY, Owner

By *Alfred Berew*
(Title)