
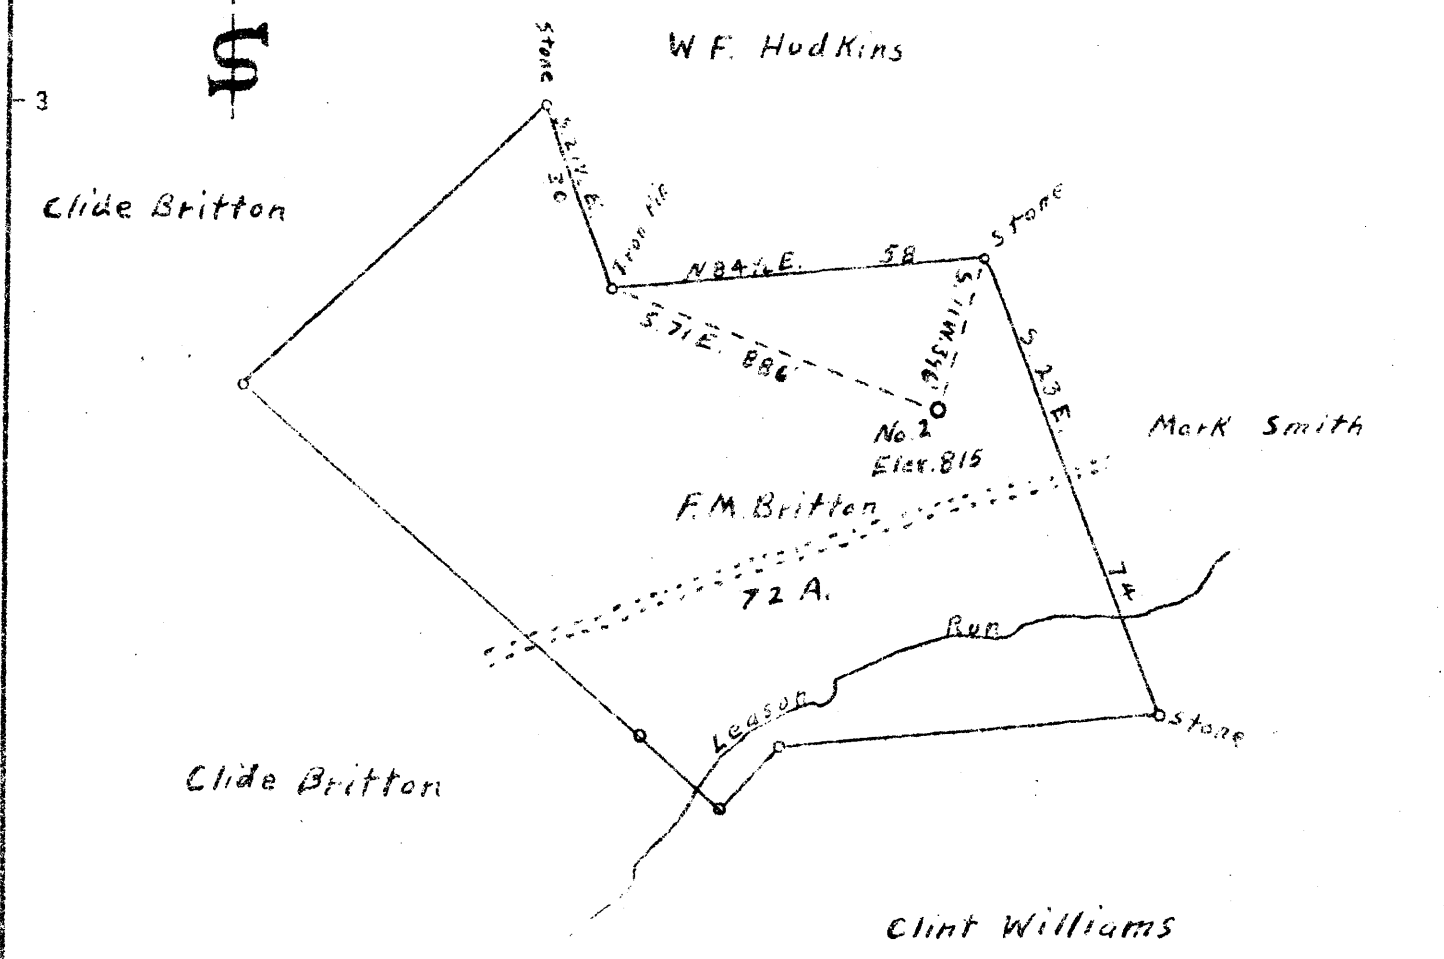


Latitude 34 15'

0.06 S
2.81 W

Longitude 80 50'

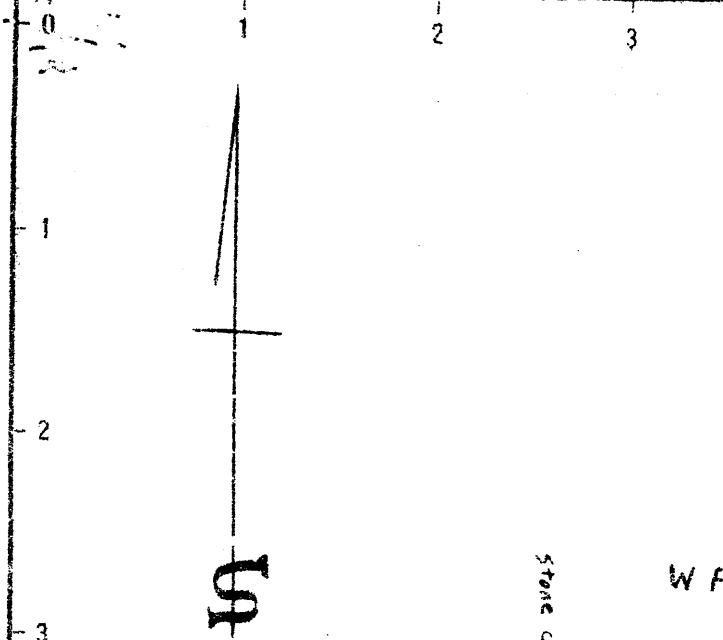

New Location
Drill Deeper
Abandonment

Company Tel. State Pipe Co
Address Bellaire, Ohio
Farm F.M. Britton
Tract _____ Acres 72 Lease No. 1
Well (Farm) No. 2 Serial No. _____
Elevation (Spirit Level) 815
Quadrangle Holbrook
County Doddridge District Central
Engineer A.K. Westfall
Engineer's Registration No. _____
File No. _____ Drawing No. _____
Date June 11, 1942 Scale 1" = 30 feet

STATE OF WEST VIRGINIA
DEPARTMENT OF MINES
OIL AND GAS DIVISION
CHARLESTON

WELL LOCATION MAP
FILE NO. DOD-514-A

+ Denotes location of well on United States Topographic Maps, scale 1 to 62 500, latitude and longitude lines being represented by border lines as shown.
- Denotes one inch spaces on border line of original tracing.

STATE OF WEST VIRGINIA
DEPARTMENT OF MINES
OIL AND GAS DIVISION

412

WELL RECORD

Permit No. 514-A

Oil or Gas Well 011
(Kind)

Company **The Tri-State Pipe Co.,**
Address **Bellaire, O.**
Farm **F.M. Britton** Acres **72**
Location (waters)
Well No. **2** Elev. **815**
District **Central** County **Doddridge**
The surface of tract is owned in fee by
Address
Mineral rights are owned by
Address
Drilling commenced
Drilling completed
Date shot Depth of shot
Open Flow /10ths Water in Inch
/10ths Merc. in Inch
Volume Cu. Ft.
Rock Pressure lbs. hrs.
Oil bbls., 1st 24 hrs.
Fresh water feet feet
Salt water feet feet

Casing and Tubing	Used in Drilling	Left in Well	Packers
Size			
16			Kind of Packer
13			
10		pulled	Size of
8 1/4		pulled	
6 3/4		1956'	Depth set
5 3/16			
3			Perf. top
2		2110'	Perf. bottom
Liners Used			Perf. top
			Perf. bottom

CASING CEMENTED SIZE No. Ft. Date
COAL WAS ENCOUNTERED AT FEET INCHES
..... FEET INCHES FEET INCHES
..... FEET INCHES FEET INCHES

Formation	Color	Hard or Soft	Top	Bottom	Oil, Gas or Water	Depth Found	Remarks
Hurry Up Sand			416	468			
Sand			895	920	<i>TT 426</i>		
Sand			1000	1090			
Little Dunkard			1125	1140	<i>P-1115</i>		
Big Dunkard			1171	1216	<i>TT 1210</i>		
Gas Sand			1405	1420			
1st Salt Sand			1460	1475	<i>TT-1430</i>		
Sand			1480	1520			
Sand			1580	1645			
Sand			1650	1700	<i>TT 1710</i>		
Sand			1710	1740			
Sand			1765	1780			
Maxon Sand			1862	1882			
Little Lime			1929	1944			
Break			1944	1946	<i>P 1976</i>		
Big Lime			1946	2017			
Injun Sand			2017	2065			
Slate & Shells			2065	2110			
Total Depth			2110				

9