


Lat. 39° 25'

Long 80° 40'

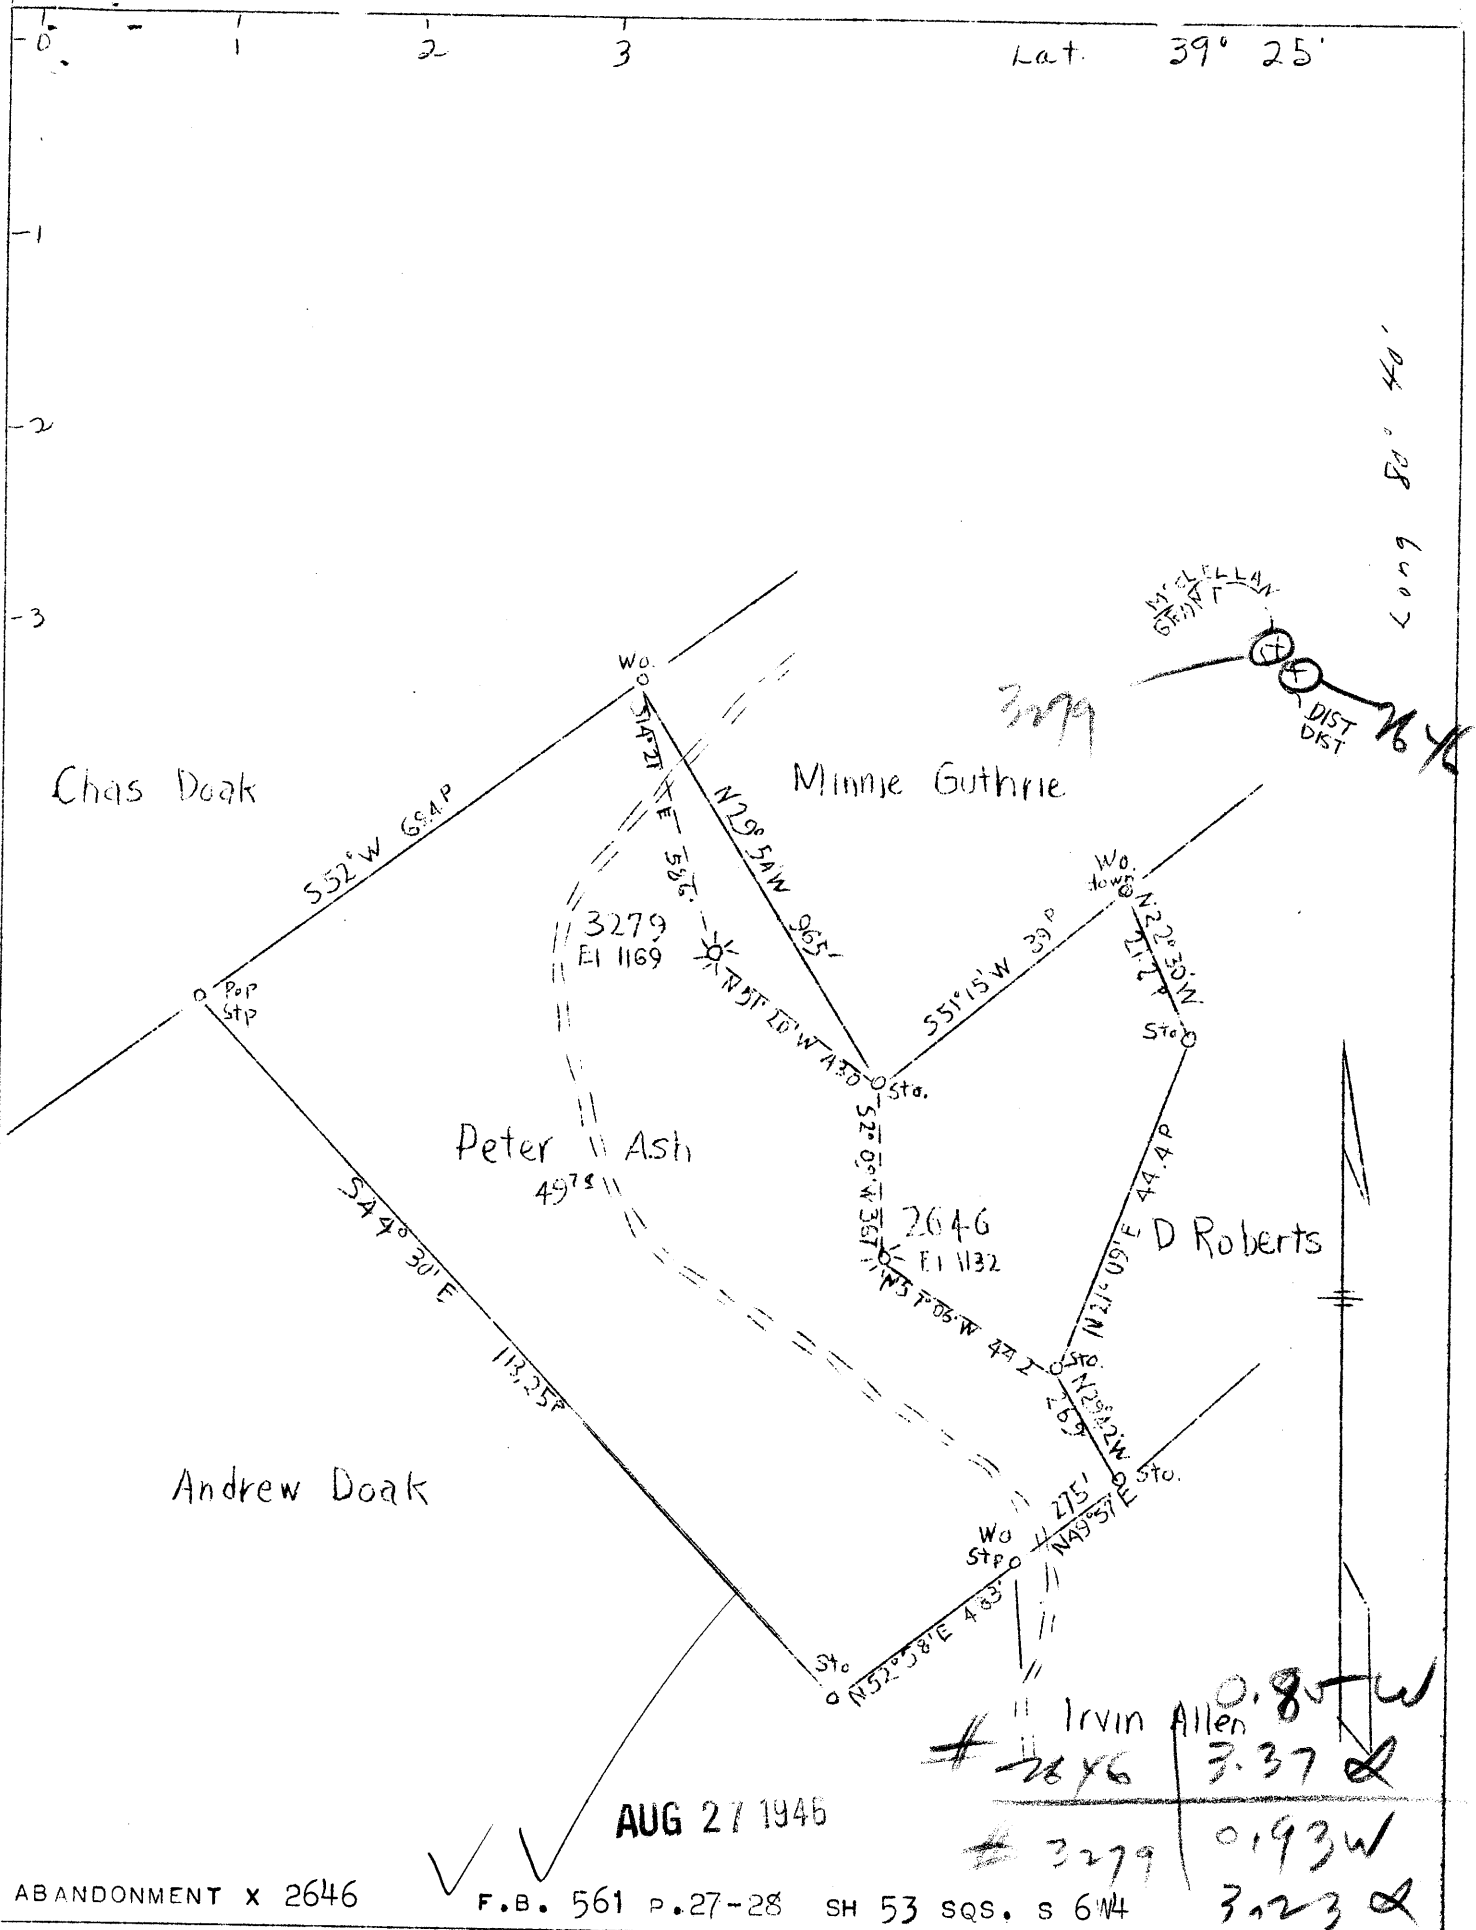

ABANDONMENT X 2646 F.B. 561 P.27-28 SH 53 SQS. S 6W4 3279 0.193W 3.223 &

COMPANY HOPE NATURAL GAS CO.
 ADDRESS CLARKSBURG, W. VA.
 FARM PETER ASH
 TRACT ACRES 50 LEASE NO. 24778
 WELL(FARM) NO. _____ SERIAL NO. SEE PLAT
 ELEVATION (SL) SEE PLAT
 QUADRANGLE CENTER POINT
 COUNTY DODDRIDGE DIST. MC SLELLAN
 ENGINEER W. M. BOWERS
 ENGINEER'S REG. NO. 900
 FILE NO. _____ DRAWING NO. _____
 DATE 26 JULY 46 SCALE 1"-400'

STATE OF WEST VIRGINIA
 DEPARTMENT OF MINES
 OIL AND GAS DIVISION
 CHARLESTON
 WELL LOCATION MAP
 FILE NO. DOD 528-A, No. 2646

1946
 527-A
 JOD

+ DENOTES LOCATION OF WELL ON U.S. TOPOGRAPHIC MAPS, SCALE 1 TO 62,500 LATITUDE AND LONGITUDE LINES BEING REPRESENTED BY BORDER LINES AS SHOWN.
 - DENOTES ONE INCH SPACES ON BORDER LINE OF ORIGINAL TRACING.

PETER ASH No. 7846 - HOPE N.G. Co - 72877 on CNG - 527-A - JOD 528-A



STATE OF WEST VIRGINIA
DEPARTMENT OF MINES
OIL AND GAS DIVISION

431

Ab 527-A (1946) ~~527-A~~ ~~pat~~

WELL RECORD

Permit No. _____ Other Gas Well _____ (KIND)

Company Hope Natural Gas Company.
 Address 445 West Main St. Clarksburg, W. Va.
 Farm Peter Ash Acres 50
 Location (waters) _____
 Well No. 2646 Elev. 1132
 District McClellan County Doddridge
 The surface of tract is owned in fee by _____
 Address _____
 Mineral rights are owned by _____
 Address _____
 Drilling commenced September 30, 1912
 Drilling completed October 24, 1912
 Date Shot _____ From _____ To _____
 With _____
 Open Flow _____ /10ths Water in _____ Inch
 _____ /10ths Merc. in _____ Inch
 Volume _____ Cu. Ft.
 Rock Pressure _____ lbs. _____ hrs.
 Oil _____ bbls., 1st 24 hrs.
 Fresh water _____ feet _____ feet
 Salt water 700 feet _____ feet

Casing and Tubing	Used in Drilling	Left in Well	Packers
Size			
16			Kind of Packer
13			
10	290	290	Size of
8 1/4	1215	1215	
6 5/8	1917	1917	Depth set
5 3/16			
3	2262	2262	Perf. top
2			Perf. bottom
Liners Used			Perf. top
			Perf. bottom

CASING CEMENTED _____ SIZE NOT No. Ft. _____ Date _____

COAL WAS ENCOUNTERED AT 740 FEET 36" INCHES
 _____ FEET _____ INCHES _____ FEET _____ INCHES
 _____ FEET _____ INCHES _____ FEET _____ INCHES

Formation	Color	Hard or Soft	Top	Bottom	Oil, Gas or Water	Depth Found	Remarks
Pittsburgh	Coal		740	743	water	700	
Big Dunkard	Gas sand		1200	1225			
			1365	1400			
First Salt			1450	1570			
Second Salt			1585	1800			
Maxon			1905	1975	gas 1915 oil & gas 1960		
Little Lime			2058	2078			
Big Lime			2078	2145			
Big Injun			2145	2249	gas	2221	
Total depth				2249			

