

New Location  
 Drill Deeper  
 Abandonment X

Map Sheet 46 Squares 53W3FB.780P29

Company	<i>Hope Natural Gas Co.</i>
Address	<i>Clarksburg, W Va</i>
Farm	<i>Henry Yeater</i>
Tract	Acres <i>35 1/2</i> Lease No. <i>44326</i>
Well (Farm) No.	Serial No. <i>7265</i>
Elevation (Spirit Level)	<i>784</i>
Quadrangle	<i>Centerpoint</i>
County	<i>Doddridge</i> District <i>McClellan</i>
Engineer	<i>W M Powers</i>
Engineer's Registration No.	<i>900</i>
File No.	Drawing No.
Date	<i>11-4-46</i> Scale <i>1" = 20 P</i>

STATE OF WEST VIRGINIA  
 DEPARTMENT OF MINES  
 OIL AND GAS DIVISION  
 CHARLESTON

**WELL LOCATION MAP**  
 FILE NO. *DOD-540-A*

+ Denotes location of well on United States Topographic Maps, scale 1 to 62,500, latitude and longitude lines being represented by border lines as shown.

- Denotes one inch spaces on border line of original tracing.



STATE OF WEST VIRGINIA  
DEPARTMENT OF MINES  
OIL AND GAS DIVISION

444

WELL RECORD

Permit No. AP 540-A


Oil or Gas Well \_\_\_\_\_ (KIND)

Company Hope Natural Gas Company.  
Address 445 West Main St. Clarksburg, W. Va.  
Farm Henry Yeater Acres 35  
Location (waters) \_\_\_\_\_  
Well No. 7265 Elev. 784  
District McClellan County Doddridge  
The surface of tract is owned in fee by \_\_\_\_\_  
Address \_\_\_\_\_  
Mineral rights are owned by \_\_\_\_\_  
Address \_\_\_\_\_  
Drilling commenced \_\_\_\_\_  
Drilling completed 1926  
Date Shot \_\_\_\_\_ From \_\_\_\_\_ To \_\_\_\_\_  
With \_\_\_\_\_  
Open Flow \_\_\_\_\_ /10ths Water in \_\_\_\_\_ Inch  
\_\_\_\_\_ /10ths Merc. in \_\_\_\_\_ Inch  
Volume \_\_\_\_\_ Cu. Ft.  
Rock Pressure \_\_\_\_\_ lbs. \_\_\_\_\_ hrs.  
Oil \_\_\_\_\_ bbls., 1st 24 hrs.  
Fresh water none recorded feet \_\_\_\_\_ feet  
Salt water none recorded feet \_\_\_\_\_ feet

Casing and Tubing	Used in Drilling	Left in Well	Packers
Size			Kind of Packer
16			
13			
10	<b>331</b>	<b>Pulled</b>	Size of
8 1/4	<b>1045</b>	<b>Pulled</b>	
6 5/8	<b>1824</b>	<b>1824</b>	Depth set
5 3/16	<b>202</b>	<b>202</b>	
3	<input checked="" type="checkbox"/> <b>2643</b>	<b>2643</b>	Perf. top
2			Perf. bottom
Liners Used			Perf. top
			Perf. bottom

CASING CEMENTED Not SIZE \_\_\_\_\_ No. Ft. \_\_\_\_\_ Date \_\_\_\_\_  
COAL WAS ENCOUNTERED AT 482 FEET 3 INCHES  
\_\_\_\_\_ FEET \_\_\_\_\_ INCHES \_\_\_\_\_ FEET \_\_\_\_\_ INCHES  
\_\_\_\_\_ FEET \_\_\_\_\_ INCHES \_\_\_\_\_ FEET \_\_\_\_\_ INCHES

Formation	Color	Hard or Soft	Top	Bottom	Oil, Gas or Water	Depth Found	Remarks
Coal			482	485			
Little Dunkard			890	899			
Big Dunkard			965	982			
<del>Third Salt</del>							
First Salt			1220	1265			
Second Salt			1292	1390			
Third Salt			1416	1445			
Maxog			1594	1712	show gas	1651	
Little Lime			1710	1740			
Big Lime			1786	1838			
Big Injun			1838	1970	gas	1882, 1944 1959	
Berea			2012	2020			
Gantz			2151	2222			
Fifty foot			2362	2384			
Thirty foot			2414	2432			
Gordon Stray			2563	2590	gas	2585 2590	
Gordon			2595	2606			
Total depth				2626			

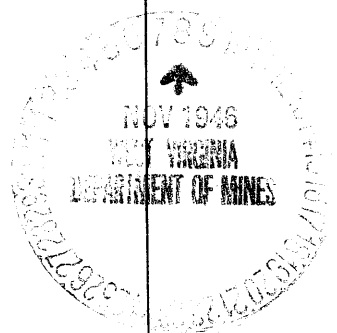

Formation	Color	Hard or Soft	Top	Bottom	Oil, Gas or Water	Depth Found	Remarks

Date **November 6, 1946.**, 19\_\_

APPROVED **Hope Natural Gas Company.**, Owner

By **General Superintendent.** (Title)

