

$$\begin{array}{r} 1.765 \\ 5 \overline{) 3.240} \\ \underline{32} \\ 1.635 \\ \underline{32} \\ 3.200 \end{array}$$

Surface, Oil & Gas, and Coal: Chas. Stewart Hrs.
 Address: Mrs. Jno. Craig, Clarksburg, W. Va.

New Location
 Drill Deeper
 Abandonment

N 37. S 4-5. W 6-7

Company Road Supply Co.
 Address Salem W. Va.
 Farm Chas. Stewart
 Tract _____ Acres 446 1/2 Lease No. _____
 Well (Farm) No. 5 and 32 Serial No. _____
 Elevation (Spirit Level) 892.95 Ground. 837.94
 Quadrangle Centerpoint
 County Doddridge District Grant
 Engineer E.C. Tabler
 Engineer's Registration No. _____
 File No. _____ Drawing No. _____
 Date Aug 7th 1946 Scale 1" = 800 Feet.

STATE OF WEST VIRGINIA
 DEPARTMENT OF MINES
 OIL AND GAS DIVISION
 CHARLESTON

WELL LOCATION MAP
 FILE NO. DOD-545-A;#5
~~DOD-546-A;#32~~

+ Denotes location of well on United States Topographic Maps, scale 1 to 62,500, latitude and longitude lines being represented by border lines as shown.
 - Denotes one inch spaces on border line of original tracing.

DOD-546 is 70563 on CN 6 maps



STATE OF WEST VIRGINIA
DEPARTMENT OF MINES
OIL AND GAS DIVISION

YVJ

WELL RECORD

Permit No. 545-A

Oil or Gas Well (KIND)


Company Read Supply Company
Address 184 East Main St., Salem, W. Va.
Farm Charles Stewart Acres 446 1/2
Location (waters) Big Flint
Well No. 5 Elev. 892.95
District Grant County Doddridge
The surface of tract is owned in fee by Chas. Stewart Hrs.
Mrs. John Craig Address Clarksburg, W. Va.
Mineral rights are owned by Chas. Stewart Hrs.
Mrs. John Craig Address Clarksburg, W. Va.

Casing and Tubing	Used in Drilling	Left in Well	Packers
Size			
16			Kind of Packer
13			
10			Size of
8 1/4			
6 1/2	1940'	1940'	Depth set
5 3/16	1322'	1322'	
3			Perf. top
2	2048'	2048'	Perf. bottom
Liners Used			Perf. top
			Perf. bottom

Drilling commenced _____
Drilling completed _____
Date Shot 5/27/14 From 2039 To _____
With 70 Qts.
Open Flow _____ /10ths Water in _____ Inch
_____ /10ths Merc. in _____ Inch
Volume _____ Cu. Ft.
Rock Pressure _____ lbs. _____ hrs.
Oil _____ bbls., 1st 24 hrs.
Fresh water _____ feet _____ feet
Salt water _____ feet _____ feet

CASING CEMENTED _____ SIZE _____ No. Ft. _____ Dat _____
COAL WAS ENCOUNTERED AT 625 FEET _____ INCHE
_____ FEET _____ INCHES _____ FEET _____ INCHE
_____ FEET _____ INCHES _____ FEET _____ INCHE

Formation	Color	Hard or Soft	Top	Bottom	Oil, Gas or Water	Depth Found	Remarks
Pittsburgh Coal			625				
Big Injun Sand			1940				
1st. Pay			1950				
2nd. Pay			2039				
Total Depth				2048			

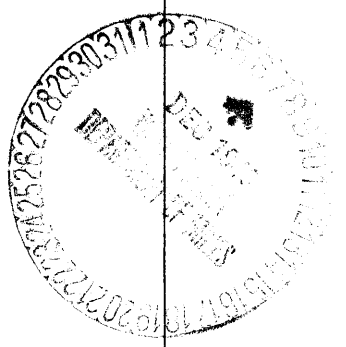

Formation	Color	Hard or Soft	Top	Bottom	Oil, Gas or Water	Depth Found	Remarks

Date December 6, 1946

APPROVED Rood Supply Co., Owner

By J. M. Rood, Mng. owner
(Title)

