


+ 1,295
0.76W

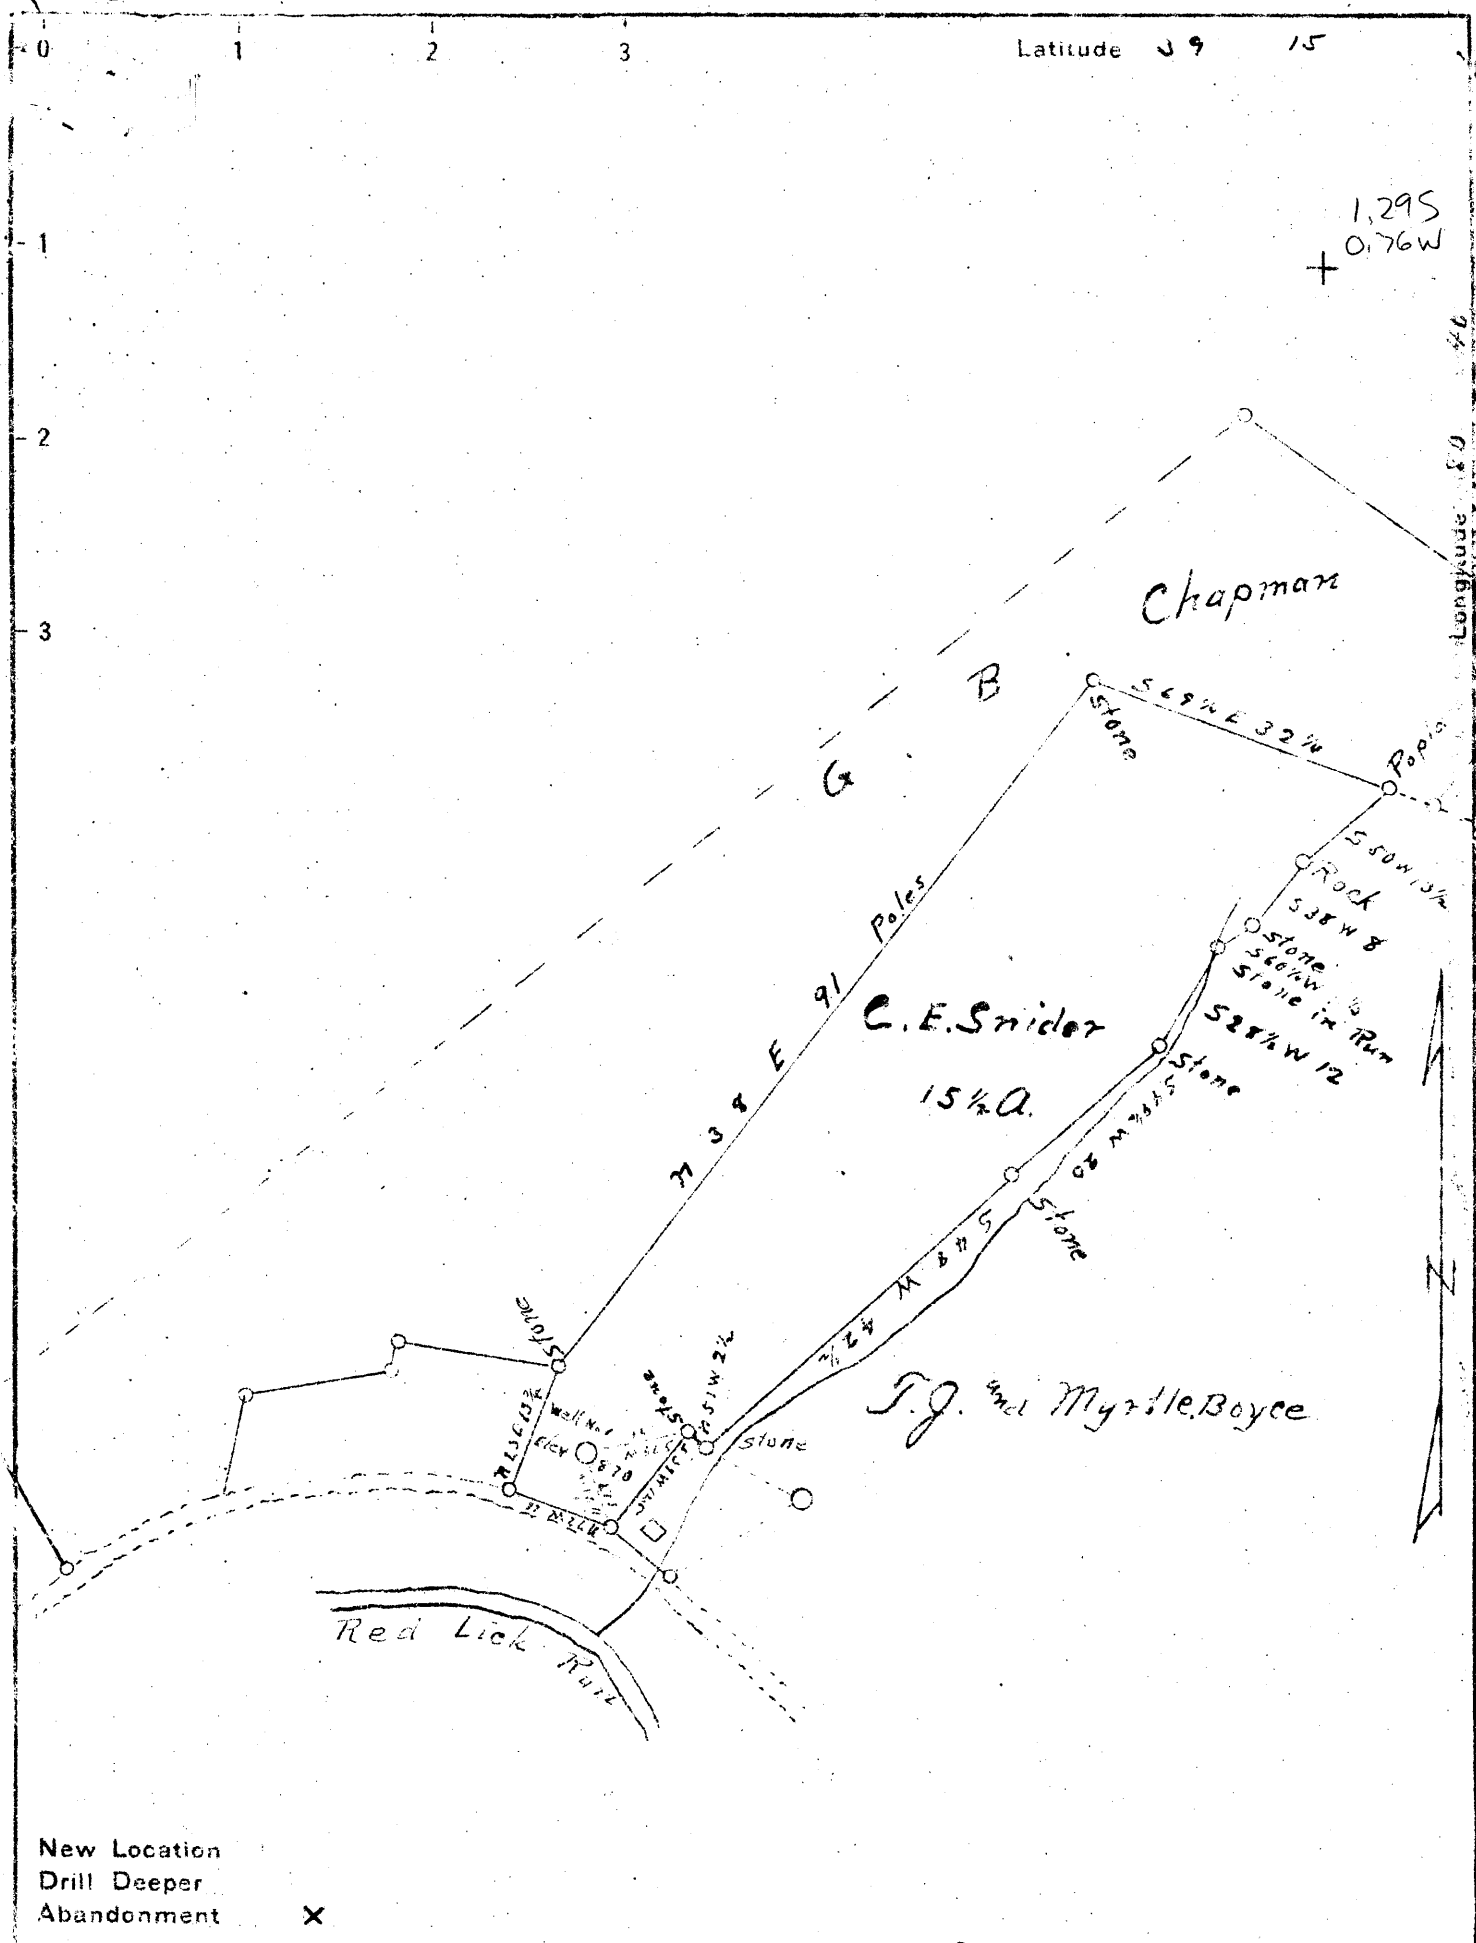

New Location
Drill Deeper
Abandonment

Company P. & M. Oil Co.
 Address West Union, W. Va.
 Farm C. E. Snider
 Tract 1 Acres 15 1/2 Lease No. _____
 Well (Farm) No. 1 Serial No. _____
 Elevation (Spirit Level) 870
 Quadrangle Vadis
 County Doddridge District New Milton
 Engineer J. M. Martin
 Engineer's Registration No. 84
 File No. _____ Drawing No. _____
 Date July 26 1946 Scale Scale 20:1

STATE OF WEST VIRGINIA
DEPARTMENT OF MINES
OIL AND GAS DIVISION
CHARLESTON

WELL LOCATION MAP
FILE NO DOD 550A

+ Denotes location of well on United States Topographic Maps, scale 1 to 62,500, latitude and longitude lines being represented by border lines as shown.
 - Denotes one inch spaces on border line of original tracing.



STATE OF WEST VIRGINIA
DEPARTMENT OF MINES
OIL AND GAS DIVISION

752

WELL RECORD

Permit No. 550 A

Oil or Gas Well X (KIND)

Company P. & M. Oil Company
Address West Union, W. Va.
Farm C. L. Snider Acres 15 1/2
Location (waters) _____
Well No. 1 Elev. 870
District New Milton County Doddridge
The surface of tract is owned in fee by _____
Address _____
Mineral rights are owned by _____
Address _____
Drilling commenced 1920
Drilling completed 1921
Date Shot _____ From _____ To _____
With _____

Casing and Tubing	Used in Drilling	Left in Well	Packers
Size			
16			Kind of Packer
13			
10	320	None	Size of
8 1/4	1065	565	
6 5/8	1891	1891	Depth set
5 3/16			
3			Perf. top
2			Perf. bottom
Liners Used			Perf. top
			Perf. bottom

Open Flow _____ /10ths Water in _____ Inch
_____ /10ths Merc. in _____ Inch
Volume _____ Cu. Ft.
Rock Pressure _____ lbs. _____ hrs.
Oil _____ bbls., 1st 24 hrs.
Fresh water _____ feet _____ feet
Salt water _____ feet _____ feet

CASING CEMENTED _____ SIZE _____ No. Ft. _____ Date _____
COAL WAS ENCOUNTERED AT 528' to 530'
FEET INCHES FEET INCHES
FEET INCHES FEET INCHES
FEET INCHES FEET INCHES

Formation	Color	Hard or Soft	Top	Bottom	Oil, Gas or Water	Depth Found	Remarks
Pittsburgh coal			528	530			
Big Dunkard			1060	1125			
Gas sand			1135	1150			
First salt			1240	1270			
Second salt			1280	1330			
Third salt			1345	1350			
Maxton			1760	1780			
Little lime			1840	1865			
Pencil cave			1865	1883			
Big lime			1883	1944			
Big Injun			1944				
Oil			1965	2000			
Total depth				2007			