


MM

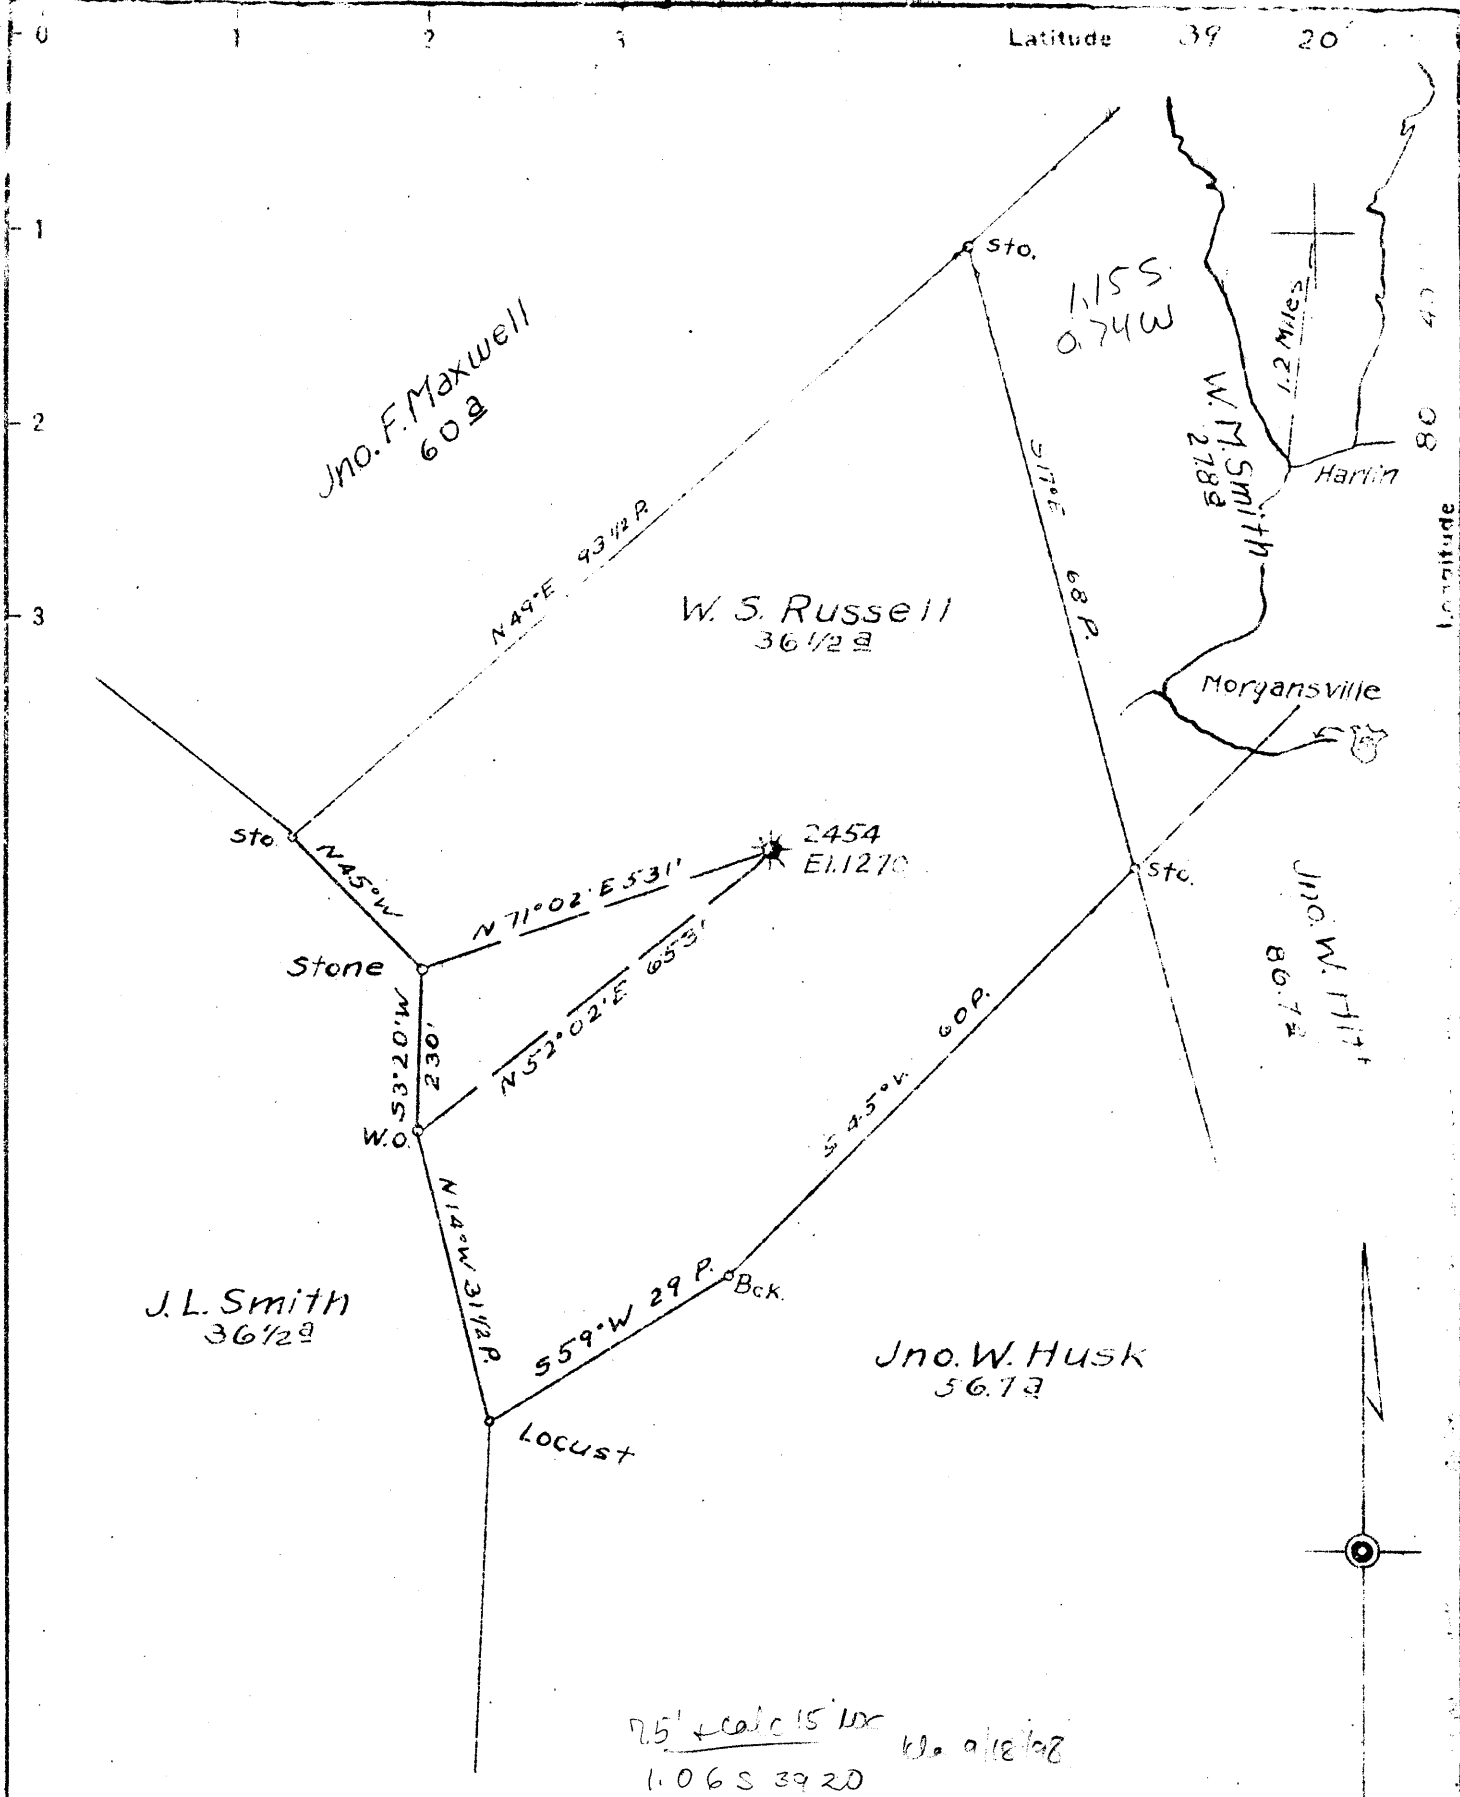

2.5' scale 15' by 10' 9/18/48  
 1.06 S 39 20  
 0.85 W 80 40

New Location  
 Drill Deeper  
 Abandonment X2454

Map Sheet 54 Square S9W4 F.B. 825 P. 29

Company	HOPE NATURAL GAS CO.
Address	CLARKSBURG W. VA.
Farm	W. S. RUSSELL
Tract	Acres 36 1/2 Lease No. 10113
Well (Farm) No.	Serial No. 2454
Elevation (Spirit Level)	1270
Quadrangle	CENTERPOINT
County	DODDRIDGE District GRANT
Engineer	W. M. Powers
Engineer's Registration No.	900
File No.	Drawing No.
Date	JAN. 23, 1947 Scale 1" = 20 POLES

STATE OF WEST VIRGINIA  
 DEPARTMENT OF MINES  
 OIL AND GAS DIVISION  
 CHARLESTON

**WELL LOCATION MAP**  
 FILE NO. DOD-552-A

+ Denotes location of well on United States Topographic Maps, scale 1 to 62,500, latitude and longitude lines being represented by border lines as shown.

- Denotes one inch spaces on border line of original tracing.