


Latitude 39° 30'

Longitude 80° 30'

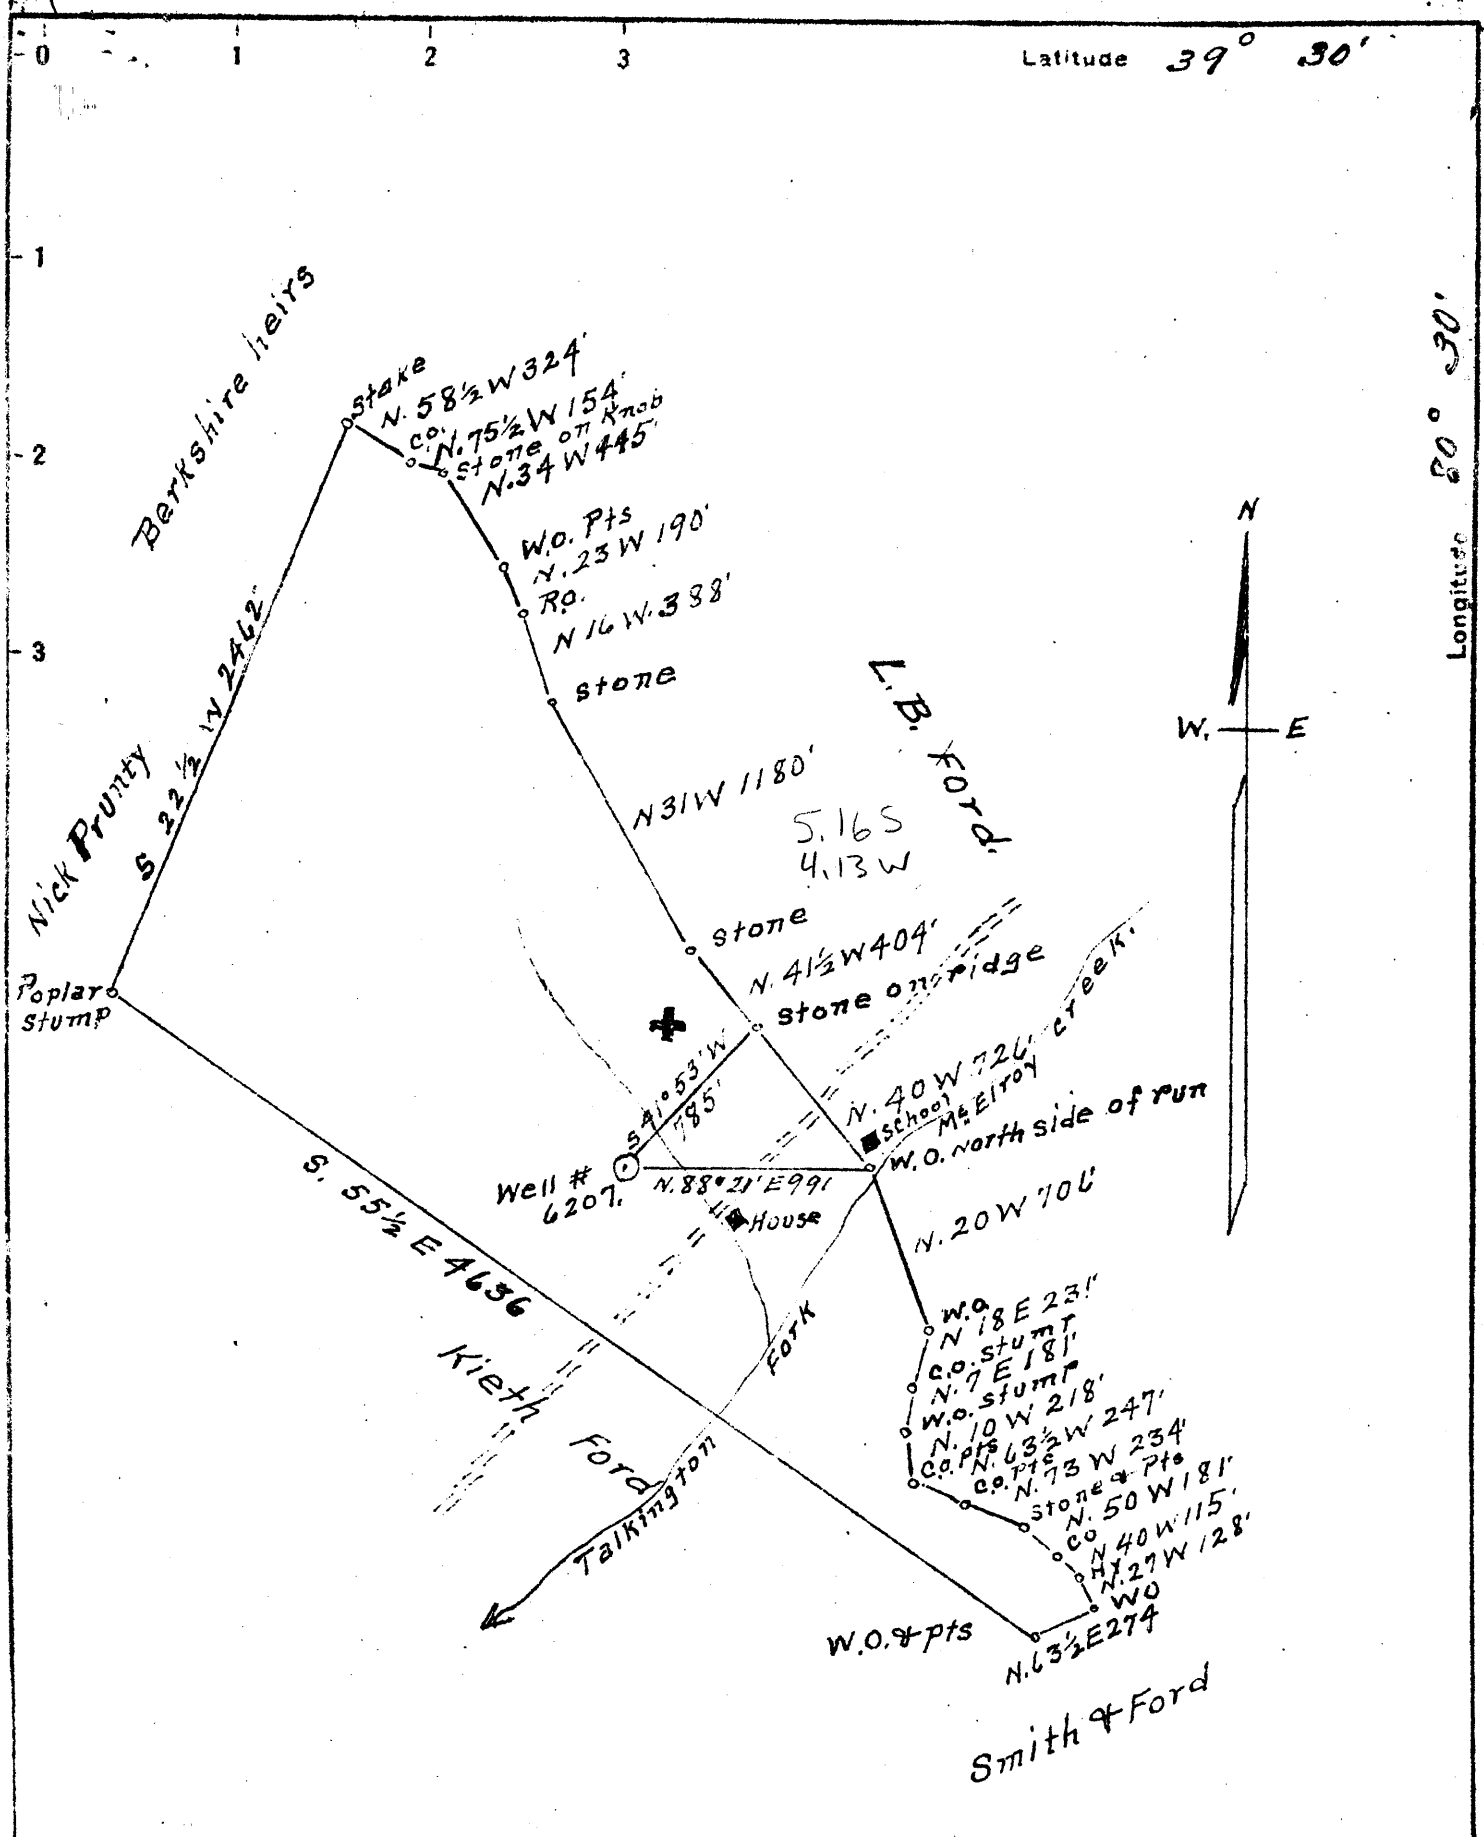

New Location
 Drill Deeper
 Abandonment

Company A.M. Snider
 Address Hundred, W Va.
 Farm Abraham Talkington
 Tract one Acres 159+ Lease No. 26599
 Well (Farm) No. one Serial No. 6207
 Elevation (Spirit Level) 970 ft
 Quadrangle Centerpoint
 County ~~Putnam~~ Dodd District McClanahan
 Engineer A. L. Headley
 Engineer's Registration No. _____
 File No. _____ Drawing No. _____
 Date 4-25-1947 Scale 1 inch = 800 ft

STATE OF WEST VIRGINIA
 DEPARTMENT OF MINES
 OIL AND GAS DIVISION
 CHARLESTON

WELL LOCATION MAP
 FILE NO. Dod-561-A

+ Denotes location of well on United States Topographic Maps, scale 1 to 62,500, latitude and longitude lines being represented by border lines as shown.
 - Denotes one inch spaces on border line of original tracing.



463

STATE OF WEST VIRGINIA
DEPARTMENT OF MINES
OIL AND GAS DIVISION

WELL RECORD

Permit No. DOD-561-A

Oil or Gas Well (KIND)

Company A. M. Snider
Address Reader, West Virginia
Farm Abraham Talkington Acres 163
Location (waters) _____
Well No. 6207 Elev. 970
District McClelland County Doddridge
The surface of tract is owned in fee by _____
Address _____
Mineral rights are owned by _____
Address _____

Drilling commenced _____
Drilling completed November 10, 1922
Date Shot _____ From _____ To _____
With _____
Open Flow _____ /10ths Water in _____ Inch
_____ /10ths Merc. in _____ Inch
Volume _____ Cu. Ft.
Rock Pressure _____ lbs. _____ hrs.
Oil _____ bbls., 1st 24 hrs.
Fresh water _____ feet _____ feet
Salt water _____ feet _____ feet

Casing and Tubing	Used in Drilling	Left in Well	Packers
Size			Kind of Packer
16			
13			
10	280	280	Size of
8 1/4	1071	1071	
6 5/8	1948	1948	Depth set
5 3/16			
3			Perf. top
2	2144	2144	Perf. bottom
Liners Used			Perf. top
			Perf. bottom

CASING CEMENTED _____ SIZE _____ No. Ft. _____ Date _____

COAL WAS ENCOUNTERED AT _____ FEET _____ INCHES
_____ FEET _____ INCHES _____ FEET _____ INCHES
_____ FEET _____ INCHES _____ FEET _____ INCHES

Formation	Color	Hard or Soft	Top	Bottom	Oil, Gas or Water	Depth Found	Remarks
Pittsburgh coal			620	630			
Big Dankard sand			980	1105			
1st Gas sand			1360	1565	Water	1375	
Maxton sand			1614	1652			
Big Injun sand			1950	2050	Gas	1968	
Squaw			2056	2088	Gas	2072	
Total depth				2133			