

Latitude 39° 20' 00"



80° 42' 30"

Longitude

**Topo Location**

7.5' Loc. 0.44S 15' Loc. 0.44S  
0.74W (calc.) 2.97W

Company \_\_\_\_\_

Farm C. Foy

15' Quad Centiput SW  
(sec.)

7.5' Quad Smithburg

District GRANT

**WELL LOCATION PLAT**


County 017 Permit 30565

**NOTE**

This well and lease was purchased from the Manufacture Light & Heat Company in the Year of 1948 by Edmond Tate who is now the owner of said lease & well

-2-

-3-

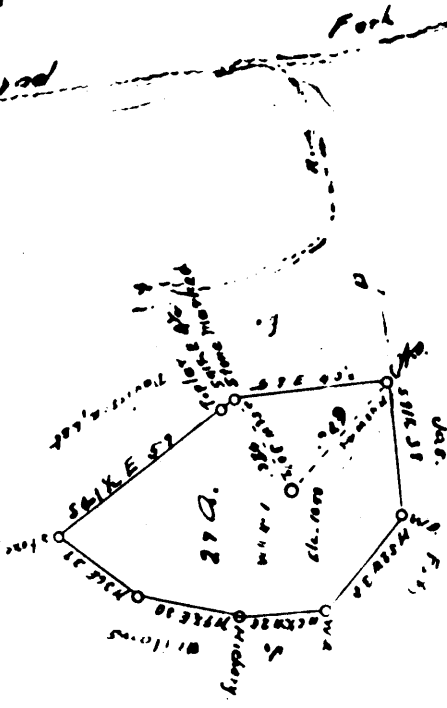

New Location   
 Drill Deeper   
 Amendment

Company Edmond Tate  
 Address Smithwood Okla.  
 Farm Challice Fax  
 Tract 22 Acres 1 Lease No. 1  
 Well (Farm) No. 1 Serial No. 1  
 Elevation (Spit Level) 1488  
 Quadrange Centerpoint  
 County Delaware Number 1

STATE OF WEST VIRGINIA  
 DEPARTMENT OF MINES  
 OIL AND GAS DIVISION  
 CHARLESTON

WELL LOCATION MAP  
 FILE NO. DOD-565-A

↑ Denotes location of well on United States



460

STATE OF WEST VIRGINIA  
DEPARTMENT OF MINES  
OIL AND GAS DIVISION

WELL RECORD

GAS Well  
Oil or Gas Well **1-1396**  
(KIND)

Permit No. **800-565-A**


Company ~~THE MANUFACTURE LIGHT & HEAT CO.~~  
Address **PARKERSBURG, W. Va.**  
Farm **Charlott~~x~~ Fox** Acres **27**  
Location (waters) **Iserale Fork**  
Well No. **1-1396** Elev. **Not Given**  
District **Grant** County **Doddridge**  
The surface of tract is owned in fee by  
**Charlott~~x~~ Fox Hrs** Address **West Union W. Va.**  
Mineral rights are owned by **Same**  
Address

Casing and Tubing	Used in Drilling	Left in Well	Packers
Size			
16			Kind of Packer
13			
10	<b>330</b>	<b>330</b>	Size of
8 1/4	<b>1628</b>	<b>1628</b>	
6 5/8	<b>2092</b>	<b>2092</b>	Depth set
5 3/16			
3			Perf. top
2			Perf. bottom
Liners Used			Perf. top
			Perf. bottom

Drilling commenced **July 22 1908**  
Drilling completed **Oct 26 1908**  
Date Shot **Oct 27** From **2780** To **2790**  
With **40 Qts Nitro-Glycerene**  
Open Flow **14**/10ths Water in **1"** Inch  
/10ths Merc. in \_\_\_\_\_ Inch  
Volume **39** Cu. Ft.  
Rock Pressure \_\_\_\_\_ lbs. \_\_\_\_\_ hrs.  
Oil \_\_\_\_\_ bbls., 1st 24 hrs.  
Fresh water \_\_\_\_\_ feet \_\_\_\_\_ feet  
Salt water **1641** feet \_\_\_\_\_ feet

CASING CEMENTED \_\_\_\_\_ SIZE \_\_\_\_\_ No. Ft. \_\_\_\_\_ Date \_\_\_\_\_  
COAL WAS ENCOUNTERED AT **650'** FEET **0** INCHES  
\_\_\_\_\_ FEET \_\_\_\_\_ INCHES FEET \_\_\_\_\_ INCHES  
\_\_\_\_\_ FEET \_\_\_\_\_ INCHES FEET \_\_\_\_\_ INCHES

Formation	Color	Hard or Soft	Top	Bottom	Oil, Gas or Water	Depth Found	Remarks
Pitab, Coal	Black	Soft	650	652			
Little Dunkard		Hard	1025	1055			
Big D. Sand		"	1155	1185			
Gas Sand		"	1200	1270			
First S. Sand		"	1450	1640	S. Water	1641	
Second S. "			1700	1870			
Maxson			1905	1920			
L. Lime			1920	1955			
Pencil Cave			1955	1950			
Big Lime			1950	2043			
Big Injun			2043	2176	Gas	2045 2168	
Gants			2320	2430			
Fifty Ft.			2540	2590			
Thirty "			2615	2645			
Stray			2650	2765			
Gordon Sand			2788	2921			
Filled up with Stone to				2809 ft			

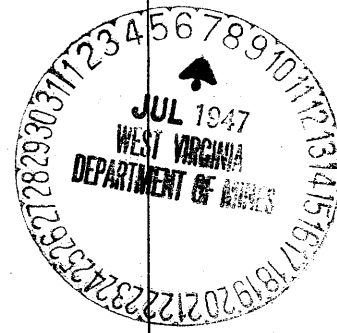

Formation	Color	Hard or Soft	Top	Bottom	Oil, Gas or Water	Depth Found	Remarks
NOTE-----	<p>This Well and lease was purchased from the Manufacture Light &amp; Heat Company in the Year of 1945 by Edmond Tate who is now the owner of said lease &amp; well</p>						

Date July 3, 19 47

APPROVED Edmond Tate, Owner

By Owner (Title)

Grant District, Doddridge County, W. Va. (Now)  
 By The Manufacturers Light & Heat Co., Parkersburg, W. Va. (EDMOND TATE).  
 Abandoned under permit Rod-.....-A1  
 On 27 acres, on Israel Fork.  
 Elevation,.....' L.  
 Surface and minerals owned by Charlotte Fox Heirs, West Union, W. Va.  
 Drilling commenced July 22, 1909; completed Oct. 26, 1909.  
 Shot Oct. 27, 1909, at 2780-2790', with 40 qts. nitroglycerine.  
 Open flow, 14/10ths W. in 1".  
 Salt water, 1641'.  
 10" casing, 330'; 8 1/2", 1628'; 6 1/2", 2092'; all left in.  
 Coal was encountered at 650-652'.  
 Gas well. Abandonment reported to Dept. of Mines July 3, 1947.  
 NOTE: This well and lease was purchased from the Manufacturers Light &  
 Heat Co. in the year 1945 by Edmond Tate who is now the owner of  
 said lease and well.  
 Gas well. Record from Mrs. Griffith to WCT Aug. 20, 1947. Old File No. 46

	Top.	Bottom.
Pittsburgh Coal, black, soft	650	- 652
Little Burkard Sand, hard	1025	- 1055
Big Burkard Sand	1155	- 1185
Gas Sand, hard	1200	- 1270
First Salt Sand (salt water, 1641')	1450	- 1640
Second Salt Sand	1700	- 1870
Horton Sand	1905	- 1920
Little Line	1920	- 1935
Pencil Cave	1935	- 1950
Big Line	1950	- 2043
Big Injun Sand (gas, 2045, 2168')	2043	- 2176
Gantz Sand	2320	- 2430
Fifty-foot Sand	2540	- 2590
Thirty-foot Sand	2615	- 2645
Stray Sand	2650	- 2765
Gordon Sand	2788	- 2921
Total depth		2921
Filled up with stone to		2809

**AFFIDAVIT OF PLUGGING AND FILLING WELLS**

AFFIDAVIT SHOULD BE MADE IN TRIPLICATE, ONE COPY MAILED TO THE DEPARTMENT ONE COPY TO BE RETAINED BY THE WELL OPERATOR AND THE THIRD COPY (AND EXTRA COPIES IF REQUIRED) SHOULD BE MAILED TO EACH COAL OPERATOR AT THEIR RESPECTIVE ADDRESSES

Charlotte Fox Hrs  
COAL OPERATOR OR OWNER  
 Rt. #2, West Union, W. Va.  
ADDRESS

Edmond Tate  
NAME OF WELL OPERATOR  
 Smithburg, W. Va.  
COMPLETE ADDRESS

Well No. 1 July 26 194<sup>8</sup>  
WELL AND LOCATION

Grant Dist District  
 Doddridge County

Well No. 1  
 Charlotte Fox Farm

STATE INSPECTOR SUPERVISING PLUGGING D. F. Desist

**AFFIDAVIT**

STATE OF WEST VIRGINIA,  
 County of Doddridge

as:

Edmond Tate and E. G. Kundell  
 being first duly sworn according to law depose and say that they are experienced in the work of  
 plugging and filling oil and gas wells and were employed by Edmond Tate  
 well operator, and participated in the work of plugging and filling the above well, that said work  
 was commenced on the 7th day of July, 1947, and that the well was plugged  
 and filled in the following manner:

DATE ON HOME RECORD	FILLING MATERIAL			PLUGS USED SIZE & KIND	CASING	
	CONTENT	FROM	TO		SEE PLUG	SEE LEFT IN
	Red Mud	2809	2450			
	Cement					
	Wood Plug			6-5/8"	2068	20
	Red Clay	2092	1638			
	Cemented					
	Wood Plug			8-1/4"	1038'	800'
	Clay	1628	700			
	Clay	700	350			350'
	Filled the 10" Casing with clay & cement to top					
<small>COAL SEAMS</small>						
<small>INDEX</small>	JUL					
<small>INDEX</small>						
<small>INDEX</small>						
<small>INDEX</small>						

DESCRIPTION OF MONUMENT

The marker was made on top with cement with 6-5/8 Re inforcement

and that the work of plugging and filling said well was completed on the 17 day of July, 1947

And further deponents saith not.

*Edmond Tate*