

Map Sh. 54 S 11 W 4, F.B. 569 P-20-24.

Company Hope Natural Gas Co  
 Address Clarksburg, W. Va.  
 Farm W. P. Taylor  
 Tract \_\_\_\_\_ Acres 57 Lease No. 10112  
 Well (Farm) No. \_\_\_\_\_ Serial No. 1122  
 Elevation. (Spirit Level) 1023'  
 Quadrangle Centerpoint  
 County Poddridge District Grant  
 Engineer W. M. Bowers  
 Engineer's Registration No. 900  
 File No. \_\_\_\_\_ Drawing No. \_\_\_\_\_  
 Date 7-9-47 Scale 1" = 400'

STATE OF WEST VIRGINIA  
 DEPARTMENT OF MINES  
 OIL AND GAS DIVISION  
 CHARLESTON

**WELL LOCATION MAP**  
 FILE NO. DOD-566-A

+ Denotes location of well on United States Topographic Maps, scale 1 to 62,500, latitude and longitude lines being represented by border lines as shown.  
 - Denotes one inch spaces on border line of original tracing.



464

STATE OF WEST VIRGINIA  
DEPARTMENT OF MINES  
OIL AND GAS DIVISION

WELL RECORD

Permit No. 1566-A


Oil or Gas Well \_\_\_\_\_ (KIND)

Company Hope Natural Gas Company.  
 Address 445 West Main St. Clarksburg, W. Va.  
 Farm W.P. Taylor Acre 57  
 Location (waters) \_\_\_\_\_  
 Well No. 1122 Elev. 1023  
 District Grant County Beddridge  
 The surface of tract is owned in fee by \_\_\_\_\_  
 Address \_\_\_\_\_  
 Mineral rights are owned by \_\_\_\_\_  
 Address \_\_\_\_\_  
 Drilling commenced February 12, 1909  
 Drilling completed March 15, 1909  
 Date Shot \_\_\_\_\_ From \_\_\_\_\_ To \_\_\_\_\_  
 With \_\_\_\_\_  
 Open Flow \_\_\_\_\_ /10ths Water in \_\_\_\_\_ Inch  
 \_\_\_\_\_ /10ths Merc. in \_\_\_\_\_ Inch  
 Volume \_\_\_\_\_ Cu. Ft.  
 Rock Pressure \_\_\_\_\_ lbs. \_\_\_\_\_ hrs.  
 Oil \_\_\_\_\_ bbls., 1st 24 hrs.  
 Fresh water \_\_\_\_\_ feet \_\_\_\_\_ feet  
 Salt water 1355 feet \_\_\_\_\_ feet

Casing and Tubing	Used in Drilling	Left in Well	Packers
Size			
16			Kind of Packer _____
13			
10	<u>970</u>	<u>970</u>	Size of _____
8 1/4	<u>1440</u>	<u>1440</u>	
6 3/4	<u>1892</u>	<u>1892</u>	Depth set _____
5 3/16			
3			Perf. top _____
2			Perf. bottom _____
Liners Used			Perf. top _____
			Perf. bottom _____

**NOT**  
 CASING CEMENTED \_\_\_\_\_ SIZE \_\_\_\_\_ No. Ft. \_\_\_\_\_ Date \_\_\_\_\_  
 COAL WAS ENCOUNTERED AT 160 FEET 36 INCHES  
452 FEET 72 INCHES FEET INCHES  
 FEET INCHES FEET INCHES

Formation	Color	Hard or Soft	Top	Bottom	Oil, Gas or Water	Depth Found	Remarks
Native coal			160	163			
Pittsburgh Coal			452	458			
Little Dunkard			770	?			
Big Dunkard			967	1000			
Gas sand			1100	1146			
First Salt			1190	1220			
Second Salt			1275	1325			
Third Salt			1330	1365	water	1355	
Maxon			1620	1635	gas	1624	
Big Lime			1750	1914			
Big Injun			1814		gas	1823 1859	
Total depth				1877			

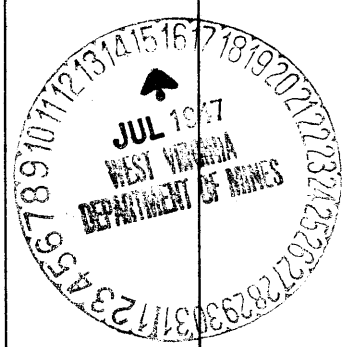

Formation	Color	Hard or Soft	Top	Bottom	Oil, Gas or Water	Depth Found	Remarks

Date **July 10, 1947**, 19

APPROVED **Hope Natural Gas Company**, Owner

By \_\_\_\_\_ (Title)

