

Surface: Mrs. Sarah Hall. Blandville Doddridge Co., W.Va.
 Coal: Gus Gabbert. Blandville. Doddridge Co., W.Va.

New Location
 Drill Deeper
 Abandonment

Map N 17 S 17 W 8

Company Broadwater Welch and Travis
 Address C. O. Travis West Union, W. Va.
 Farm Mary E. Gabbert
 Tract _____ Acres 47 1/2 Lease No. _____
 Well (Farm) No. 1 Serial No. _____
 Elevation (Spirit Level) 1058.96
 Quadrangle HOLBROOK
 County Doddridge District New Milton
 Engineer E. C. Tabler
 Engineer's Registration No. _____
 File No. _____ Drawing No. _____
 Date July 25th 1947 Scale 1" = 400 Feet.

STATE OF WEST VIRGINIA
 DEPARTMENT OF MINES
 OIL AND GAS DIVISION
 CHARLESTON

WELL LOCATION MAP
 FILE NO. 100d-577-A

+ Denotes location of well on United States Topographic Maps, scale 1 to 62,500, latitude and longitude lines being represented by border lines as shown.
 - Denotes one inch spaces on border line of original tracing.



STATE OF WEST VIRGINIA
DEPARTMENT OF MINES
OIL AND GAS DIVISION

776

WELL RECORD

Permit No.

Oil or Gas Well Oil

(KIND)


Company Broadwater, Welch & Travis
Address C. O. Travis, West Union, W. Va.
Farm Mary K. Gabbert Acres 47 1/2
Location (waters) Lick Run
Well No. 1 Elev.
District New Milton County Doddridge
The surface of tract is owned in fee by Sarah Hall
Address Bladville, W. Va.

Casing and Tubing	Used in Drilling	Left in Well	Packers
Size			
16			Kind of Packer
13			
10	<u>285</u>	<u>none</u>	Size of
8 1/4	<u>335</u>	<u>none</u>	
6 1/2	<u>1903'6"</u>	<u>1905'6"</u>	Depth set
5 3/16			
3			Perf. top
2			Perf. bottom
Liners Used			Perf. top
			Perf. bottom

Mineral rights are owned by
Address
Drilling commenced
Drilling completed July 23, 1900
Date Shot From To
With
Open Flow /10ths Water in Inch
 /10ths Merc. in Inch
Volume Cu. Ft.
Rock Pressure lbs. hrs.
Oil bbls., 1st 24 hrs.
Fresh water feet feet
Salt water feet feet

CASING CEMENTED SIZE No. Ft. Date
COAL WAS ENCOUNTERED AT FEET INCHES
 FEET INCHES FEET INCHES
 FEET INCHES FEET INCHES

Formation	Color	Hard or Soft	Top	Bottom	Oil, Gas or Water	Depth Found	Remarks
Hurry up Sand			220	275			
Salt Sand			1181	1282			
Maxon Sand			1400	1520			
Big Lime			1735	1795			
Big Injun			1794	1820	Oil (Show)	1845	
Stray Sand			2445	2449			
Gorden Sand			2452	2460	Oil	2452-60	
Total Depth				2480			

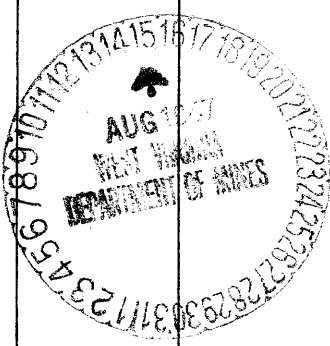

C

Formation	Color	Hard or Soft	Top	Bottom	Oil, Gas or Water	Depth Found	Remarks

Date **August 9**, 19**47**

APPROVED **Broadwater, Welch & Travis**, Owner

By _____ (Title)



New Milton District, Doddridge County, W. Va.
By South Penn Oil Co.

~~099~~
NOV 30 5 77

	Top.	Bottom.
Hurry-up Sand	220	- 275
Salt Sand	1181	- 1282
Maxton Sand	1400	- 1520
Little Lime	1641	- 1675
Pencil Cave	1675	- 1685
Big Lime	1735	- 1794
Big Injun Sand (oil show, 1845')	1794	- 1820
Gordon Sand	2452	- 2460
Total depth		2480