


2.33 S
0.1° E

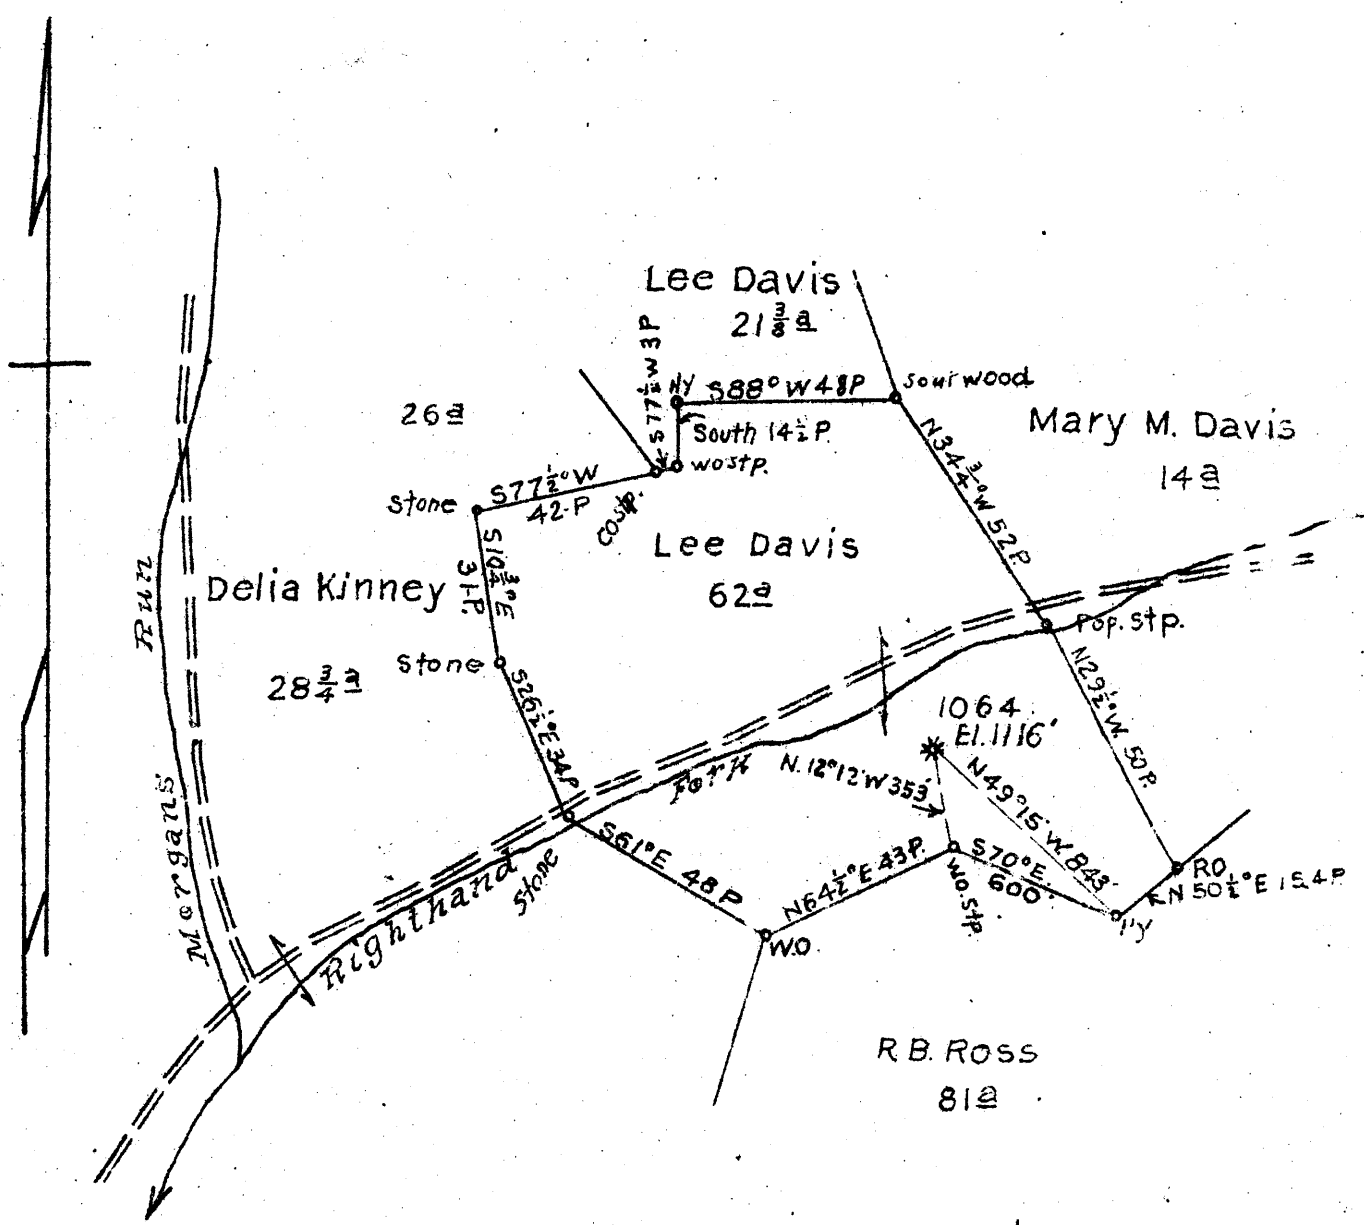

New Location.....
 Drill Deeper.....
 Abandonment..... X

Map Sh. 54 Sq. S10W4 FB. 564 P 32

Company	Hope Natural Gas Co.
Address	Clarksburg, W. Va.
Farm	Lee Davis
Tract	Acres 60 Lease No. 4678
Well (Farm) No.	Sérial No. 1064
Elevation (Spirit Level)	1116'
Quadrangle	Centerpoint
County	Dodridge District Grant
Engineer	W. M. Bowers
Engineer's Registration No.	900
File No.	Drawing No.
Date	11-25-47 Scale 1" = 40 P

STATE OF WEST VIRGINIA
 DEPARTMENT OF MINES
 OIL AND GAS DIVISION
 CHARLESTON

WELL LOCATION MAP
 FILE NO. DOD-585-A

+ Denotes location of well on United States Topographic Maps, scale 1 to 62,500, latitude and longitude lines being represented by border lines as shown.

- Denotes one inch spaces on border line of original tracing.

72662 on CNG map



402

STATE OF WEST VIRGINIA
DEPARTMENT OF MINES
OIL AND GAS DIVISION

WELL RECORD

Permit No.


~~Oil~~ or Gas Well (KIND)

Company Hope Natural Gas Company.
Address 445 West Main St. Clarksburg, W. Va.
Farm Lee Davis Acres 62
Location (waters)
Well No. 1064 Elev. 1116
District Grant County Doddridge
The surface of tract is owned in fee by
 Address
Mineral rights are owned by
 Address
Drilling commenced June 27, 1908
Drilling completed Aug. 22, 1908
Date Shot From To
With
Open Flow /10ths Water in Inch
 /10ths Merc. in Inch
Volume Cu. Ft.
Rock Pressure lbs. hrs.
Oil bbls., 1st 24 hrs.
Fresh water none recorded feet feet
Salt water none recorded feet feet

Casing and Tubing	Used in Drilling	Left in Well	Packers
Size			
16			Kind of Packer
18	87	Pulled	
10	1120	Pulled	Size of
8 1/4	1722	1722	
6%	2026	2026	Depth set
5 3/16			
3			Perf. top
2			Perf. bottom
Liners Used			Perf. top
			Perf. bottom

NOT
CASING CEMENTED SIZE No. Ft. Date
COAL WAS ENCOUNTERED AT FEET INCHES
568 FEET 72 INCHES FEET INCHES
 FEET INCHES FEET INCHES

Formation	Color	Hard or Soft	Top	Bottom	Oil, Gas or Water	Depth Found	Remarks
Pittsburgh Coal			568	574			
Little Dunkard			985	1025			
Big Dunkard			1110	1130			
First Salt			1405	1498			
Second Salt			1560	1668			
Maxon			1715	1775	gas	1755 1760	
Little Lime			1775	1800			
Pencil cave			1800	1815			
Big Lime			1815	1925			
Big Injun			1925	2028	gas	1930 1953	
Squaw			2048	2051			
Total depth				2130			

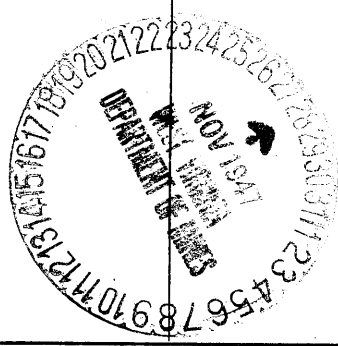

Formation	Color	Hard or Soft	Top	Bottom	Oil, Gas or Water	Depth Found	Remarks

Date November 25, 1947, 19

APPROVED Hope Natural Gas Company, Owner

By _____

(Title) 