

Scale 1" = 800 feet

Mrs. Smith, 200 1/2	
1	4.19 S 4.18 W
3	3.61 S 4.37 W
4	4.04 S 4.02 W
6	4.05 S 4.32 W

Pittsburgh Coal & Surface, 1 & 4 Albert Percy
 E. Porter Bode, RFD #1, Blandville, Doddridge Co. W. Va.
 Pittsburgh Coal, 3 & 6 Albert Percy; New Milton, Doddridge Co. W. Va.
 Surface, 3 Albert Percy; Paul W. Clevenger, RFD #1, Blandville, Dodd. Co. W. Va.
 Surface, 6 Albert Percy; Mr. Fay Barnett, RFD #1, Blandville, Doddridge Co. W. Va.

Abandonment

Company The Tri-State Pipe Co.
 Address Bellaire, Ohio
 Farm Albert Percy
 Tract Acres 375' Lease No.
 Well (Farm) No. 1, 3, 4 & 6 Serial No. 6
 Elevation (Spirit Level) 6 feet above Ground - 1196.39
 Quadrangle VADIS
 County Doddridge District New Milton
 Engineer E. C. Tabler
 Engineer's Registration No. _____
 File No. _____ Drawing No. _____
 Date Dec. 19th & 20th 1947 Scale 1" = 800'

STATE OF WEST VIRGINIA
 Department of Mines
 OIL & GAS DIVISION
 Charleston

WELL LOCATION MAP
 File No. DOD - 591-A-#1
DOD - 592-A-#3
DOD - 593-A-#4
DOD - 594-A-#6

+ Denotes location of well on U.S. Topographic Maps, scale 1 to 62,500, latitude & longitude lines being represented by border lines as shown.
 - Denotes one inch spaces on border line of original tracing.



489

STATE OF WEST VIRGINIA
DEPARTMENT OF MINES
OIL AND GAS DIVISION

WELL RECORD

Permit No. 593 A

Oil or Gas Well (X)
(K120)


Company The Tri-State Pipe Co.
 Address Bellaire, Ohio
 Farm Albert Percy Heirs Acres 27
 Location (waters) _____
 Well No. 4 Elev. 2927
 District New Milton County Doddridge
 The surface of tract is owned in fee by _____
 Address _____
 Mineral rights are owned by _____
 Address _____
 Drilling commenced _____
 Drilling completed 10-14-13
 Date Shot _____ From _____ To _____
 With _____

Casing and Tubing	Used in Drilling	Left in Well	Packers
Size			Kind of Packer
16			
13			
10	392'	392'	Size of
8 1/2	1050'	None	
6	1878'	1878'	Depth set
5 3/16			
3			Perf. top
2	2568'	2568'	Perf. bottom
Liners Used			Perf. top
			Perf. bottom

Open Flow _____ /10ths Water in _____ Inch
 _____ /10ths Merc. in _____ Inch
 Volume _____ Cu. Ft.
 Rock Pressure _____ lbs. _____ hrs.
 Oil _____ bbls., 1st 24 hrs.
 Fresh water _____ feet _____ feet
 Salt water _____ feet _____ feet

CASING CEMENTED _____ SIZE _____ No. Ft. _____ Dat _____
 COAL WAS ENCOUNTERED AT _____ FEET _____ INCHES
 _____ FEET _____ INCHES _____ FEET _____ INCHES
 _____ FEET _____ INCHES _____ FEET _____ INCHES

Formation	Color	Hard or Soft	Top	Bottom	Oil, Gas or Water	Depth Found	Remarks
Dunkard Sand			1297'	1347'			
Big Lime			1834'	1899			
Big Injun			1900	1975			
Gordon Sand			2525				
Oil			2529	Oil	Oil		
Oil			2533	Oil	Oil		
Slate			2542	2568			
Total Depth				2568			

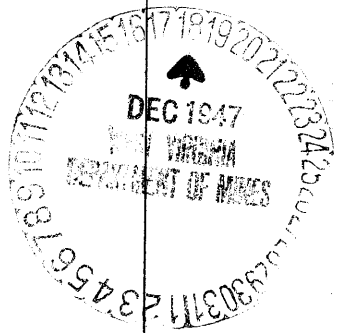

Formation	Color	Hard or Soft	Top	Bottom	Oil, Gas or Water	Depth Found	Remarks

Date December 16, 194

APPROVED The Tri-State Pipe Co., Owner

By J. M. Raad Contractor
(Title)
 5m