


M

Latitude 37° 18'

1.505
0.48W

Longitude 80° 40'

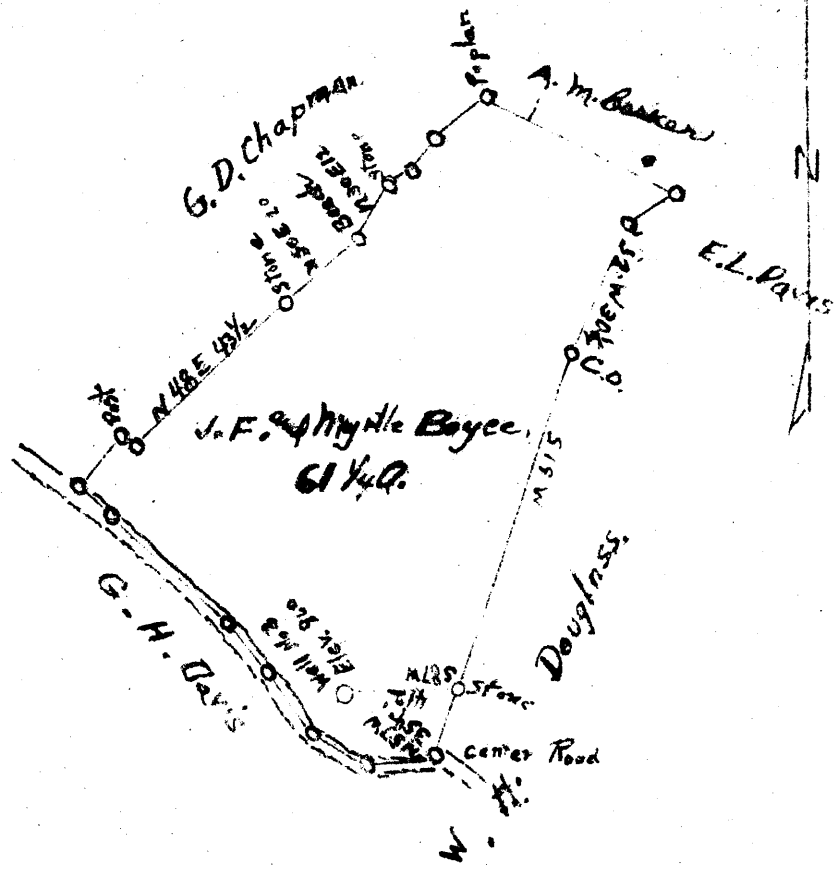

New Location
 Drill Deeper
 Abandonment

Company P. & M. Oil Co.
 Address West Union, W. Va.
 Farm J. F. Myrtle Boyce
 Tract 0216 Acres 6 1/4 Lease No. _____
 Well (Farm) No. 3 Serial No. _____
 Elevation (Spirit Level) 960
 Quadrangle Vadis
 County Doddridge District New Milton
 Engineer J. M. Martin
 Engineer's Registration No. 84
 File No. _____ Drawing No. _____
 Date March 5 1948 Scale 40

STATE OF WEST VIRGINIA
 DEPARTMENT OF MINES
 OIL AND GAS DIVISION
 CHARLESTON

WELL LOCATION MAP
 FILE NO. DOD-610-A

+ Denotes location of well on United States Topographic Maps, scale 1 to 62,500, latitude and longitude lines being represented by border lines as shown.
 - Denotes one inch spaces on border line of original tracing.



519

STATE OF WEST VIRGINIA
DEPARTMENT OF MINES
OIL AND GAS DIVISION

WELL RECORD

Permit No. _____

Oil or Gas Well OIL

Company P. & M. Oil Company
 Address West Union, W. Va.
 Farm T. T. Boyce Acres 61
 Location (waters) Red Lick Run
 Well No. 3 Elev. 960
 District New Milton County Doddridge
 The surface of tract is owned in fee by T. J. Boyce
 Address New Milton, W. Va.
 Mineral rights are owned by _____
 Address _____
 Drilling commenced February 11, 1921
 Drilling completed March 26, 1921
 Date Shot _____ From _____ To _____
 With _____
 Open Flow _____ /10ths Water in _____ Inch
 _____ /10ths Merc. in _____ Inch
 Volume _____ Cu. Ft.
 Rock Pressure _____ lbs. _____ hrs.
 Oil _____ bbls., 1st 24 hrs.
 Fresh water _____ feet _____ feet
 Salt water _____ feet _____ feet

Casing and Tubing	Used in Drilling	Left in Well	Packers
Size			Kind of Packer
16			
13			
10	350'		Size of
8 1/4	1100'		
6 3/4	1934'	1934'	Depth set
5 3/16			
3			Perf. top
2			Perf. bottom
Liners Used			Perf. top
			Perf. bottom

CASING CEMENTED _____ SIZE _____ No. Ft. _____ Date _____
 COAL WAS ENCOUNTERED AT _____ FEET _____ INCHES
 _____ FEET _____ INCHES _____ FEET _____ INCHES
 _____ FEET _____ INCHES _____ FEET _____ INCHES

Formation	Color	Hard or Soft	Top	Bottom	Oil, Gas or Water	Depth Found	Remarks	
P. coal			576	580				
Little Dunkard			990	1000				
Big Dunkard			1091	1175				
1st salt			1345	1465				
2d salt			1625	1690				
Maxton			1800	1825				
Little lime			1890	1910				
Pencil cave			1910	1925				
Big lime			1925	1982		Gas & Oil	1982-1989	
Big Injun			1982	2046		Gas & Oil	2007-2021	
						Oil	2036-2046	
Total depth				2060				

JUL 23 1943