

1125
0.50 W

- New Location
- Drill Deeper
- Abandonment

Map Sh 68 S 21 W 9 E B. 890 P-13 -16.

Company Hope Natural Gas Co.
 Address Clarksburg, W.Va.
 Farm H.C. Bode
 Tract _____ Acres 112 Lease No. 13764
 Well (Farm) No. _____ Serial No. 3084
 Elevation (Spirit Level) 1070'
 Quadrangle Holbrook
 County Doddridge District Cove
 Engineer Wm Bowers
 Engineer's Registration No. 900
 File No. _____ Drawing No. _____
 Date 3-15-48 Scale 1"=40P

STATE OF WEST VIRGINIA
 DEPARTMENT OF MINES
 OIL AND GAS DIVISION
 CHARLESTON

WELL LOCATION MAP
 FILE NO. DOD-611-A

+ Denotes location of well on United States Topographic Maps, scale 1 to 62,500, latitude and longitude lines being represented by border lines as shown.

- Denotes one inch spaces on border line of original tracing

73356 on CNG map



497

STATE OF WEST VIRGINIA
DEPARTMENT OF MINES
OIL AND GAS DIVISION

WELL RECORD

Permit No. OH-AR

Oil or Gas Well _____
(KIND)


Company Hopa Natural Gas Company.
Address 445 West Main St. Clarksburg, W. Va.
Farm H.C. Bode Acres 112
Location (waters) _____
Well No. 3084 Elev. 1070
District Cava County Doddridge
The surface of tract is owned in fee by _____
Address _____
Mineral rights are owned by _____
Address _____
Drilling commenced August 4, 1913
Drilling completed Sept. 22, 1913
Date Shot _____ From _____ To _____
With _____

Casing and Tubing	Used in Drilling	Left in Well	Packers
Size			
16			Kind of Packer _____
13			
10	268	268	Size of _____
8 1/4	910	910	
6 5/8	1993	1993	Depth set _____
5 3/16			
3			Perf. top _____
2			Perf. bottom _____
Liners Used			Perf. top _____
			Perf. bottom _____

Open Flow _____ /10ths Water in _____ Inch
_____ /10ths Merc. in _____ Inch
Volume _____ Cu. Ft.
Rock Pressure _____ lbs. _____ hrs.
Oil _____ bbls., 1st 24 hrs.
Fresh water none recorded feet _____ feet
Salt water none recorded feet _____ feet

CASING CEMENTED _____ SIZE _____ No. Ft. _____ Date _____
COAL WAS ENCOUNTERED AT 385 FEET 24 INCHES
_____ FEET _____ INCHES _____ FEET _____ INCHES
_____ FEET _____ INCHES _____ FEET _____ INCHES

Formation	Color	Hard or Soft	Top	Bottom	Oil, Gas or Water	Depth Found	Remarks
Pittsburgh Coal			385	387			
Little Dunkard			885	910			
Big Dunkard			1160	1188			
Gas sand			1235	1290			
First Salt			1362	1417			
Second Salt			1531	1615			
Maxon			1825	1872			
Little Line			1905	1918			
Pencil cave			1918	1921			
Big Line			1921	1973			
Big Injun			1972		gas	2039	
Total depth				2057			

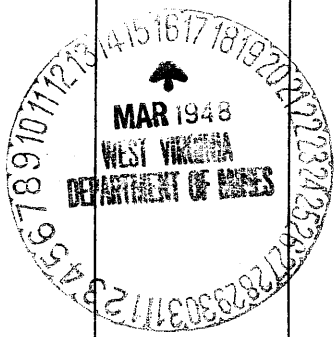

Formation	Color	Hard or Soft	Top	Bottom	Oil, Gas or Water	Depth Found	Remarks

Date March 3, 1948., 19

APPROVED Hope Natural Gas Company., Owner

By _____

(Title)

JAM