


Latitude 39° 10'

6-1,775
4.30W

Geo. W. Albers Hrs.

Longitude 80° 40'

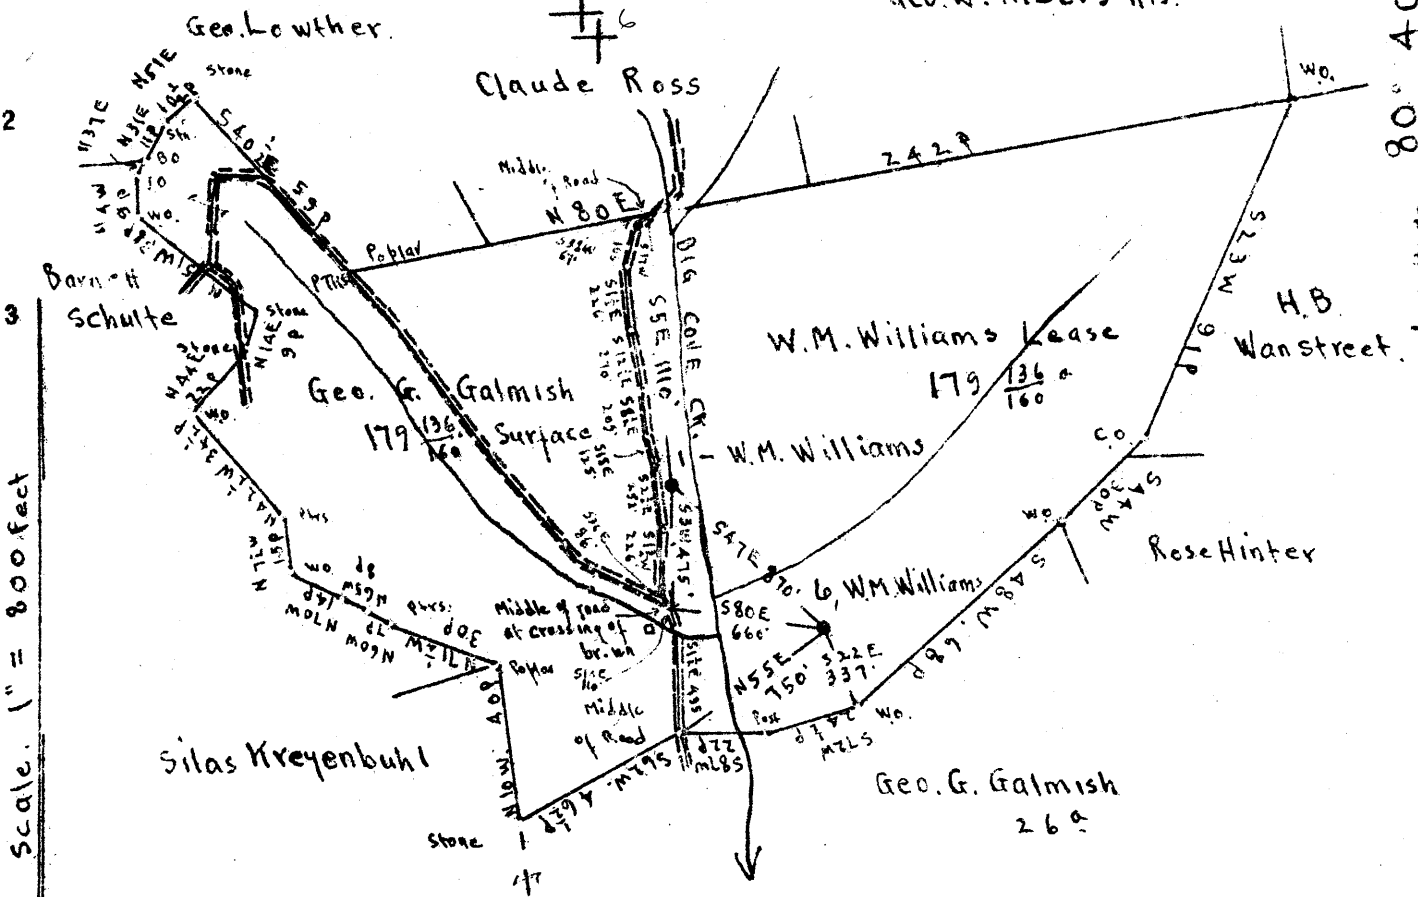

Surface: Geo. G. Galmish, R.F.D #1, Blandville, Doddridge Co., W.Va.

Pittsburgh Coal: Formerly W.M. Williams Hrs.
now State of West Virginia.

New Location
 Drill Deeper
 Abandonment

On 800' Map # 7

521. W8

Company The Tri-State Pipe Co

Address Bellaire Ohio

Farm W.M. Williams

Tract Acres 180 Lease No.

Well (Farm) No. 1st 6 Serial No.
 Elevation (Spirit Level) #1. Floor. 898.76
 #6. Floor. 1084.87

Quadrangle VADIS

County Doddridge District Cove

Engineer E.C. Tabler

Engineer's Registration No.

File No. Drawing No.

Date Feb. 14th 1948 Scale 1" = 800 Feet

STATE OF WEST VIRGINIA
 DEPARTMENT OF MINES
 OIL AND GAS DIVISION
 CHARLESTON

WELL LOCATION MAP

FILE NO. DOD-604A #1
DOD-621-A-#6

+ Denotes location of well on United States Topographic Maps, scale 1 to 62,500, latitude and longitude lines being represented by border lines as shown.

- Denotes one inch spaces on border line of original tracing.



STATE OF WEST VIRGINIA
DEPARTMENT OF MINES
OIL AND GAS DIVISION

573

Ad 621-A

WELL RECORD

Permit No. _____

Oil or Gas Well _____
(KIND)

Company The Tri-State Pipe Company
Address Bellaire, O.
Farm W.M. Williams Acres 179
Location (waters) _____
Well No. 6 Elev. 18487
District Dove County Doddridge
The surface of tract is owned in fee by _____
Address _____
Mineral rights are owned by _____
Address _____

Drilling commenced _____
Drilling completed 12/22/16
Date Shot 10/1/29 From _____ To _____
With Top of Shot 2751
Bottom " 2761
Open Flow _____ /10ths Water in _____ Inch
_____ /10ths Merc. in _____ Inch
Volume _____ Cu. Ft.
Rock Pressure _____ lbs. _____ hrs.
Oil _____ bbls., 1st 24 hrs.
Fresh water _____ feet _____ feet
Salt water _____ feet _____ feet

Casing and Tubing	Used in Drilling	Left in Well	Packers
Size			
16			Kind of Packer _____
13			
10	685	Pa 516d	Size of _____
8 1/2	20	20	
6 1/2	2085	2085	Depth set _____
5 3/16	590 Liner	590	
3			Perf. top _____
2			Perf. bottom _____
Liners Used	5-3/16		Perf. top _____
			Perf. bottom _____

CASING CEMENTED _____ SIZE _____ No. Ft. _____ Date _____
COAL WAS ENCOUNTERED AT _____ FEET _____ INCHES
_____ FEET _____ INCHES FEET _____ INCHES
_____ FEET _____ INCHES FEET _____ INCHES

Formation	Color	Hard or Soft	Top	Bottom	Oil, Gas or Water	Depth Found	Remarks
Red Rock Cave			685	1250			
Cow Run 1st			1250	1270			
Cow Run 2nd			1344	1395			
1st Salt			1675	1735			
2nd Salt			1765	1795			
3rd Salt			1860	1920			
Maxon Sand			1992	2032			
Little Lime			2032	2052			
Pencil Cave			2052	2060			
Big Lime			2060	2130			
Big Injun			2130	2210			
Gas			2177				
Squaw			2300	2440			
Gordon Stray			2752	2758			
Oil			2757				
Total Depth				2776			