

Map Sh 59 511 W 7 F.B. 895 P 18-19

New Location  
 Drill Deeper  
 Abandonment X

Company Hope Natural Gas Co.  
 Address Clarksburg, W. Va.  
 Farm Andrew Davisson  
 Tract \_\_\_\_\_ Acres 100 Lease No. 11723  
 Well (Farm) No. \_\_\_\_\_ Serial No. 1033  
 Elevation (Spirit Level) 916'  
 Quadrangle Centerpoint  
 County Dodridge District West Union  
 Engineer W.M. Bewers  
 Engineer's Registration No. 900  
 File No. \_\_\_\_\_ Drawing No. \_\_\_\_\_  
 Date 5-7-48 Scale 1" = 30 P

STATE OF WEST VIRGINIA  
 DEPARTMENT OF MINES  
 OIL AND GAS DIVISION  
 CHARLESTON

**WELL LOCATION MAP**  
 FILE NO. DOD-645-A

+ Denotes location of well on United States Topographic Maps, scale 1 to 62,500, latitude and longitude lines being represented by border lines as shown.

- Denotes one inch spaces on border line of original tracing.

72528 on CNG map



STATE OF WEST VIRGINIA  
DEPARTMENT OF MINES  
OIL AND GAS DIVISION

535

AP 645A

WELL RECORD

Permit No. \_\_\_\_\_

Oil or Gas Well \_\_\_\_\_ (KIND)

Company Hope Natural Gas Company.  
Address 445 West Main St. Clarksburg, W. Va.  
Farm Andrew Davisson Acres 100  
Location (waters) \_\_\_\_\_  
Well No. 1033 Elev. 916  
District West Union County Doddridge  
The surface of tract is owned in fee by \_\_\_\_\_  
Address \_\_\_\_\_

Mineral rights are owned by \_\_\_\_\_  
Address \_\_\_\_\_  
Drilling commenced \_\_\_\_\_  
Drilling completed October 30, 1904  
Date Shot \_\_\_\_\_ From \_\_\_\_\_ To \_\_\_\_\_  
With \_\_\_\_\_


Open Flow /10ths Water in \_\_\_\_\_ Inch  
/10ths Merc. in \_\_\_\_\_ Inch  
Volume \_\_\_\_\_ Cu. Ft.  
Rock Pressure \_\_\_\_\_ lbs. \_\_\_\_\_ hrs.  
Oil \_\_\_\_\_ bbls., 1st 24 hrs.  
Fresh water none recorded feet \_\_\_\_\_ feet  
Salt water none recorded feet \_\_\_\_\_ feet

Casing and Tubing	Used in Drilling	Left in Well	Packers
Size			
16			Kind of Packer
18			
10	92	Pulled	Size of
8 1/4			
6%	1635	1635	Depth set
5 3/16	1664	1664	
3			Perf. top
2			Perf. bottom
Liners Used			Perf. top
			Perf. bottom

CASING CEMENTED \_\_\_\_\_ SIZE not No. Ft. \_\_\_\_\_ Date \_\_\_\_\_  
COAL WAS ENCOUNTERED AT 255 FEET 36 INCHES  
\_\_\_\_\_ FEET \_\_\_\_\_ INCHES FEET \_\_\_\_\_ INCHES  
\_\_\_\_\_ FEET \_\_\_\_\_ INCHES FEET \_\_\_\_\_ INCHES

Formation	Color	Hard or Soft	Top	Bottom	Oil, Gas or Water	Depth Found	Remarks
Pittsburgh Coal			255	258			
Maxon			1365	1415			
Big Injun			1712	1800			
Berea			1940	2010			
Stray			2350	2358			
Gordon			2362	2367	gas	2363	
Total depth				2374			

(C)

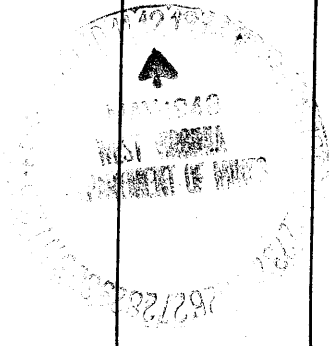

Formation	Color	Hard or Soft	Top	Bottom	Oil, Gas or Water	Depth Found	Remarks

Date May 5, 1948, 19

APPROVED Hope Natural Gas Company., Owner

By \_\_\_\_\_

(Title)

*HN 1*