


Scale. 1" = 800 Feet

Longitude 80° 45'

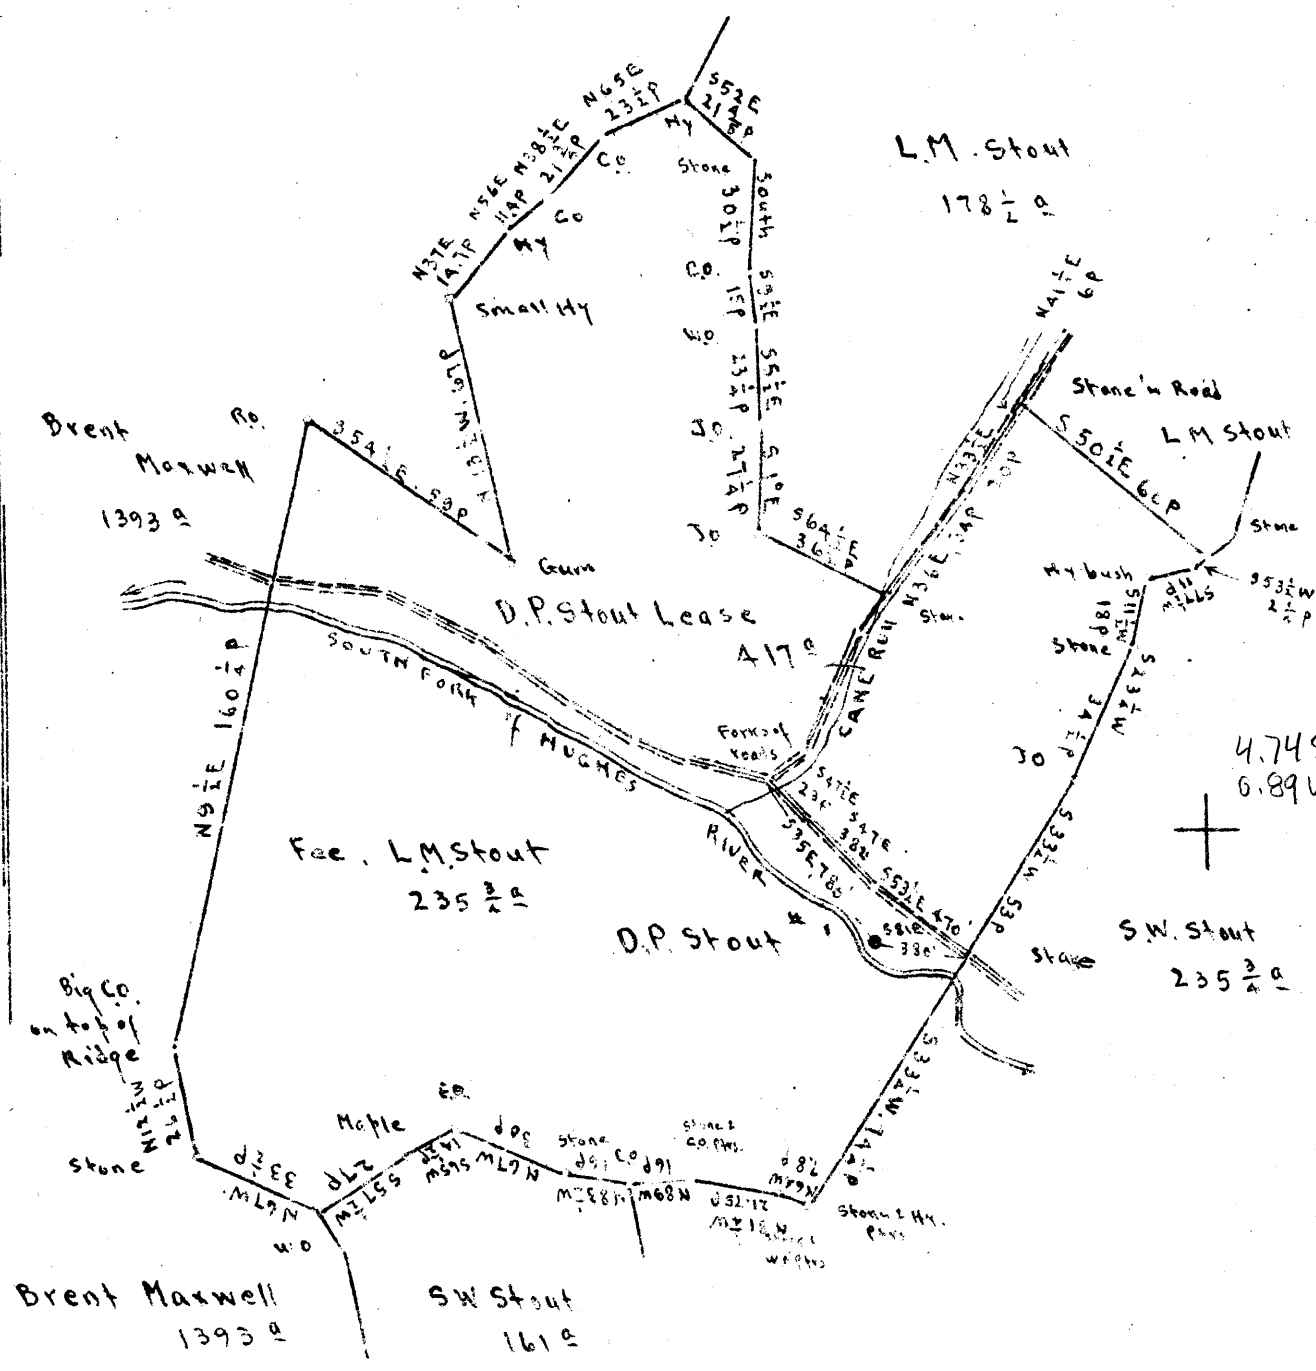

Surface, Coal (if any), Oil & Gas: L.M. Stout,
RFD #1, Blandville, Doddridge Co. W. Va.

- New Location
- Drill Deeper
- Abandonment

Map N 17

S 18-19 W 9

Company The Tri-State Pipe Co.
 Address Bellaire, Ohio
 Farm D.P. Stout
 Tract _____ Acres 417 Lease No. _____
 Well (Farm) No. 1 Serial No. _____
 Elevation (Spirit Level) Floor = 912.88
 Ground = 910.88
 Quadrangle HOLBROOK
 County Doddridge District Southwest
 Engineer E.C. Tabler
 Engineer's Registration No. _____
 File No. _____ Drawing No. _____
 Date May 14th 1948 Scale 1" = 800 Feet

STATE OF WEST VIRGINIA
 DEPARTMENT OF MINES
 OIL AND GAS DIVISION
 CHARLESTON

WELL LOCATION MAP
 FILE NO. DOD-655-A

+ Denotes location of well on United States Topographic Maps, scale 1 to 62,500, latitude and longitude lines being represented by border lines as shown.

- Denotes one inch spaces on border line of original tracing.



STATE OF WEST VIRGINIA
DEPARTMENT OF MINES
OIL AND GAS DIVISION

543

AP 655-A

WELL RECORD

Permit No. _____ Oil or Gas Well _____ (KIND)

Company The Tri-State Pipe Co.,
 Address Bellaire, O.
 Farm D. P. Stout Acres 417
 Location (waters) _____
 Well No. 1 Elev. 912.88
 District Southwest County Doddridge
 The surface of tract is owned in fee by L.M. Stout
RFD #1, Blandville Address Doddridge Co., W. Va.
 Mineral rights are owned by L.M. Stout
 Address _____
 Drilling commenced _____ Date Shot _____
 Drilling completed 9/4/99 1/4/03 9/18/06
 Date Shot 9/3/01 From 0/4/19 to 7/29/30
 With _____

Casing and Tubing	Used in Drilling	Left in Well	Packers
Size			Packers & Shoe Kind of Packer <u>None</u>
10	<u>250</u>	<u>Pulled 250</u>	Size of _____
8	<u>930</u>	<u>" 930</u>	Depth set _____
6	<u>1555</u>		Perf. top _____
5 3/16	<u>1621</u>		Perf. bottom _____
4 1/4	<u>774</u>		Perf. top _____
2			Perf. bottom _____

Open Flow _____ /10ths Water in _____ Inch
 _____ /10ths Merc. in _____ Inch
 Volume _____ Cu. Ft.
 Rock Pressure _____ lbs. _____ hrs.
 Oil _____ bbls., 1st 24 hrs.
 Fresh water _____ feet _____ feet
 Salt water _____ feet _____ feet

CASING CEMENTED _____ SIZE _____ No. Ft. _____ Date _____

COAL WAS ENCOUNTERED AT _____ FEET _____ INCHES
 _____ FEET _____ INCHES FEET _____ INCHES
 _____ FEET _____ INCHES FEET _____ INCHES

Formation	Color	Hard or Soft	Top	Bottom	Oil, Gas or Water	Depth Found	Remarks
Cow Run 1st			930	950			
1st Salt			1200	1300			
Water			1200				
Maxon			1470	1490			
Gas			1490				
Big Lime			1550	1640			
Big Injun			1640	1740			
Gordon Stray			2325	2340			
Gordon			2348	2354			
Oil			2349	2353			
Total Depth				2373			

