

Surface: D.C. Snider Hrs. Mrs. Hattie Snider, Widow, Life Interest.
 Address, Friend Snider, RFD #1, Blandville, Doddridge Co., W.Va.
 Coal: J.H. Boda Hrs. Address, Jas. H. Boda, RFD. #2, Richwood, Ohio.

New Location...
 Drill Deeper.....
 Abandonment.....

On 800' Map # 7 320 W 8-9

Company The Tri-State Pipe Co.
 Address Bellaire Ohio
 Farm J.H. Boda
 Tract _____ Acres 169 7/8 Lease No. _____
 Well (Farm) No. 356 & 9 Serial No. _____
 Elevation (Spirit Level) See above in NE Corner
 Quadrangle HOLBROOK
 County Doddridge District Cove
 Engineer E.C. Tabler
 Engineer's Registration No. _____
 File No. _____ Drawing No. _____
 Date March 5th 1948 Scale 1" = 800 Feet.

STATE OF WEST VIRGINIA
 DEPARTMENT OF MINES
 OIL AND GAS DIVISION
 CHARLESTON

WELL LOCATION MAP

FILE NO. DOD-678-A-#3
DOD-684-A-#9
DOD-687-A-#5

+ Denotes location of well on United States Topographic Maps, scale 1 to 62,500, latitude and longitude lines being represented by border lines as shown.

- Denotes one inch spaces on border line of original tracing.

"IMPERIAL" TRACING CLOTH
 K & E CO., N. Y.



STATE OF WEST VIRGINIA
DEPARTMENT OF MINES
OIL AND GAS DIVISION

581

WELL RECORD

Permit No. 687-A

Oil or Gas Well _____ (KIND)

Company Tri-State Pipe Company
Address Bellaire, O.
Farm J. H. Bode Acres 169
Location (waters) _____
Well No. 5 Elev. _____
District ove County Doddridge
The surface of tract is owned in fee by _____
Address _____
Mineral rights are owned by _____
Address _____
Drilling commenced _____
Drilling completed 6/15/1901
Date Shot 1901 From 2646 To _____
With 1902 2646


Casing and Tubing	Used in Drilling	Left in Well	Packers
Size			Kind of Packer
16			
13			
10	<u>345 1/2</u>	<u>Pulled</u>	Size of
8 3/4	<u>1160</u>	<u>"</u>	
6 3/4	<u>1513</u>		Depth set
5 3/16	<u>2151</u>		
3			Perf. top
2			Perf. bottom
Liners Used			Perf. top
			Perf. bottom

Open Flow _____ /10ths Water in _____ Inch
_____ /10ths Merc. in _____ Inch
Volume _____ Cu. Ft.
Rock Pressure _____ lbs. _____ hrs.
Oil _____ bbls., 1st 24 hrs.
Fresh water _____ feet _____ feet
Salt water _____ feet _____ feet

CASING CEMENTED _____ SIZE _____ No. Ft. _____ Date _____

COAL WAS ENCOUNTERED AT _____ FEET _____ INCHES
_____ FEET _____ INCHES _____ FEET _____ INCHES
_____ FEET _____ INCHES _____ FEET _____ INCHES

Formation	Color	Hard or Soft	Top	Bottom	Oil, Gas or Water	Depth Found	Remarks
Conductor				16			
Salt Sand			1420	1480			
Maxon Sand			1779	1840			
Big Lime			1950	2017			
Big Injun			2017	2127			
Stray Sand			2637	2642			
Gordon Sand			2647	2651			
Oil			2647				
Total Depth				2662			

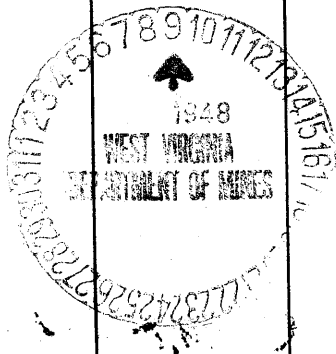

J. H. BODE NO. 5 WELL.

Cove District, Doddridge County, W. Va.

By Tri-State Pipe Co., Bellaire, Ohio.

Abandoned under permit Dod-~~687~~-A1

On 169 acres.

Elevation, ^{1052.78} 78.1 L.

Drilling completed June 15, 1901.

Shot in 1901 at 2646'; in 1902, at 2646'.

10" casing, 345½' (pulled); 8¼", 1160' (pulled); 6⅝", 1513'; 5⅜", 2151'.

Oil well. Record to Dept. of Mines stamped.....9, 1948.

Record to RCT from Mrs. Griffith Jan. 22, 1949. Old File No. 581.

	Top.	Bottom.
Conductor	0	16
Salt Sand	1420	1480
Maxton Sand	1779	1840
Big Lime	1950	2017
Big Injun Sand	2017	2127
Stray Sand	2637	2642
Gordon Sand (oil, 2647')	2647	2651
Total depth		2662

