

New Location
 Drill Deeper
 Abandonment X

Survey *A. K. Westfall*

Company *E. S. Woodyard Est. & Paul Cromwell*
 Address *Pennsboro, W. Va.*
 Farm *Charles Stewart*
 Tract _____ Acres _____ Lease No. _____
 Well (Farm) No. *9-22* Serial No. _____
 Elevation (Spirit Level) *952-1094* *WC*
 Quadrangle *Centerpoint*
 County *Doddridge* District *Grant*
 Engineer *B. Finchert*
 Engineer's Registration No. *648*
 File No. _____ Drawing No. _____
 Date *9/3/48* Scale *1" = 60 P.*

STATE OF WEST VIRGINIA
 DEPARTMENT OF MINES
 OIL AND GAS DIVISION
 CHARLESTON

WELL LOCATION MAP
 FILE NO. *DOD-691-A-#9*
DOD-696-A-#22

+ Denotes location of well on United States Topographic Maps, scale 1 to 62,500, latitude and longitude lines being represented by border lines as shown.
 - Denotes one inch spaces on border line of original tracing.



STATE OF WEST VIRGINIA
DEPARTMENT OF MINES
OIL AND GAS DIVISION

589

WELL RECORD

Permit No. 691-A


Oil or Gas Well Oil
(KIND)

Company E.S. Woodyard Estate & Paul Cromwell
Address Box 578, Pennsboro, W. Va.
Farm Charles Stewart Acres _____
Location (waters) Flint Run
Well No. 9 Elev. 952
District Grant County Doddridge
The surface of tract is owned in fee by Charles Stewart
Address _____
Mineral rights are owned by Charles Stewart
Address _____
Drilling commenced Unknown
Drilling completed Unknown
Date Shot Unknown From _____ To _____
With _____
Open Flow /10ths Water in _____ Inch
/10ths Merc. in _____ Inch
Volume _____ Cu. Ft.
Rock Pressure _____ lbs. _____ hrs.
Oil _____ bbls., 1st 24 hrs.
Fresh water _____ feet _____ feet
Salt water _____ feet _____ feet

Casing and Tubing	Used in Drilling	Left in Well	Packers
Size			
16			Kind of Packer
13			
10			Size of
8 1/4			
6 1/2	1958'	1958'	Depth set
5 3/16			
3			Perf. top
2			Perf. bottom
Liners Used			Perf. top
			Perf. bottom

CASING CEMENTED _____ SIZE _____ No. Ft. _____ Date _____
COAL WAS ENCOUNTERED AT NO FEET _____ INCHES
_____ FEET _____ INCHES FEET _____ INCHES
_____ FEET _____ INCHES FEET _____ INCHES

Formation	Color	Hard or Soft	Top	Bottom	Oil, Gas or Water	Depth Found	Remarks
Pitts. coal			620'				
Big Injun			1944'				
1st Pay			1950'				
2nd Pay			2035'				
Total depth				2059'			

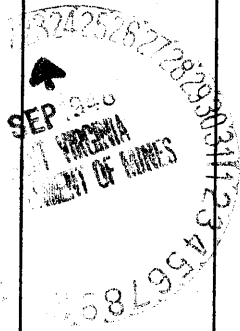

(Over)

JAN 22 1949

Formation	Color	Hard or Soft	Top	Bottom	Oil, Gas or Water	Depth Found	Remarks

Date Sept. 21, 19 48

APPROVED E.S. Woodyard Estate & Paul Cromwell, Owner

By Paul Cromwell Partner.
(Title)

Grant District, Doddridge County, W. Va.
 By E. S. Woodyard Estate and Paul Cromwell, Box 578, Pennsboro, W. Va.
 Abandoned under permit Dod-.....-A?
 On.....acres.
 Elevation, 952' L.
 Surface and minerals owned by Charles Stewart.
 Date of completion, etc., unknown.
 6 $\frac{3}{8}$ " casing, 1956'.
 No coal was encountered.
 Oil well. Abandonment reported to Dept. of Mines Sept. 21, 1948.
 Record to RCT from Mrs. Griffith Jan. 22, 1949. Old File No. 589.

	Top.	Bottom.
Pittsburgh Coal	620 -	...
Big Injun Sand	1944 -
(1st pay, 1950'; 2nd pay, 2035')		
Total depth		2059