


Latitude 39° 20'

Longitude 80° 45'

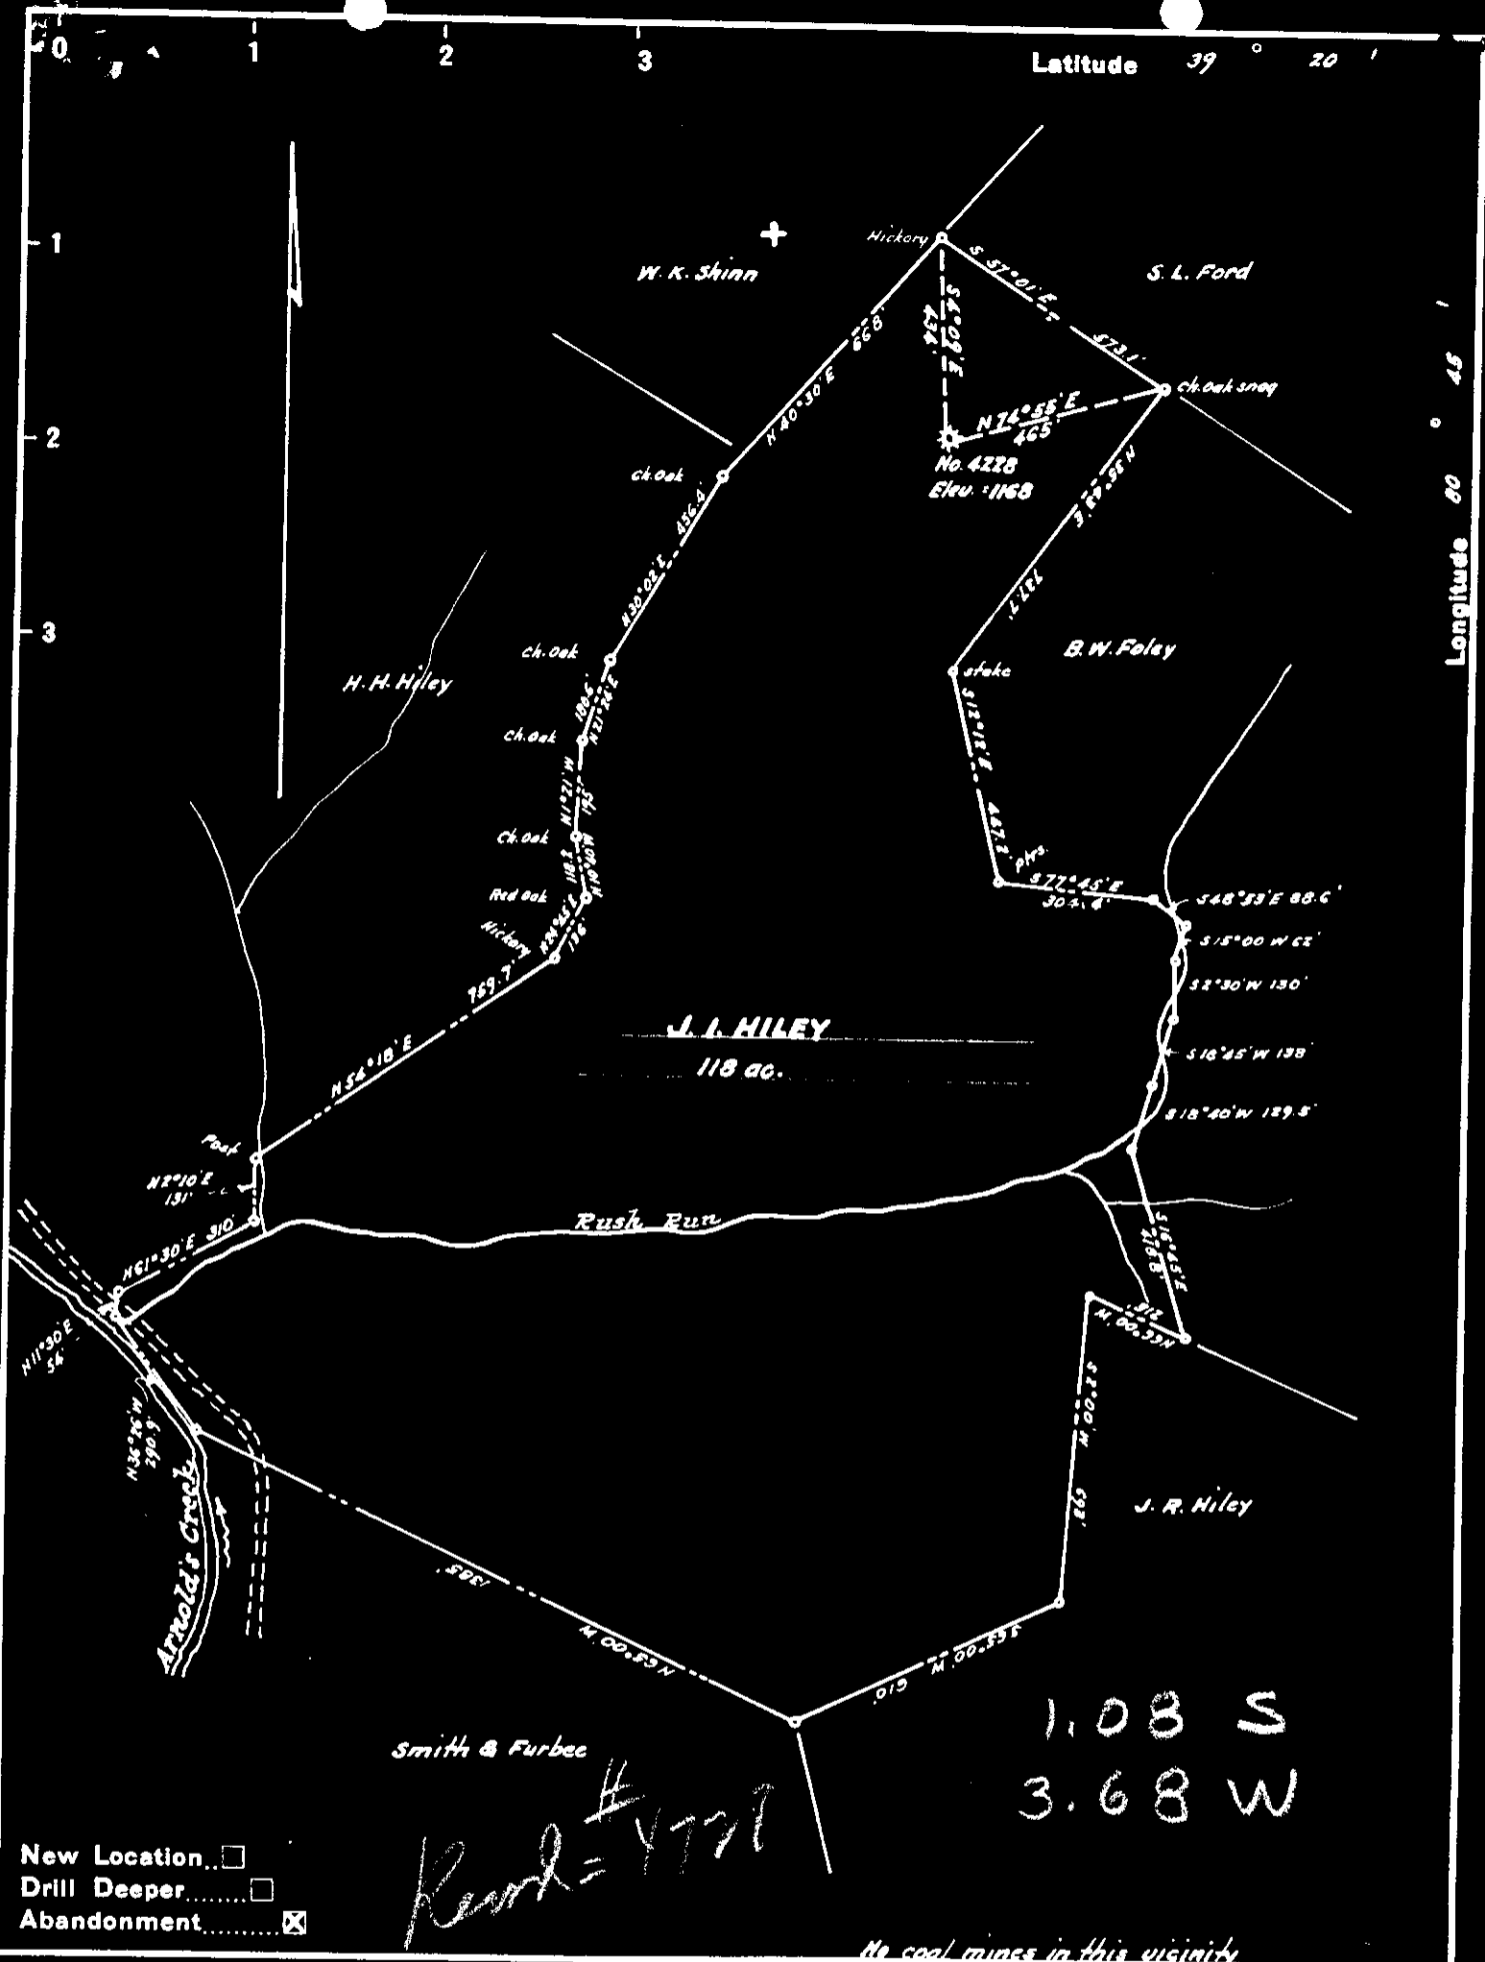

- New Location
- Drill Deeper
- Abandonment

Revd = 4778

*1.08 S
3.68 W*

No coal mines in this vicinity

Company W.D. GRIBBLE

Address West Union, W. Va.

Farm J.L. Hiley

Tract _____ Acres 118 Lease No. _____

Well (Farm) No. _____ Serial No. _____

Elevation (Spirit Level) 1168

Quadrangle West Union

County Doddridge District Central

Engineer W.D. Gribble

Engineer's Registration No. 1227

File No. _____ Drawing No. _____

Date Sept. 1948 Scale 1" = 400'

STATE OF WEST VIRGINIA
DEPARTMENT OF MINES
OIL AND GAS DIVISION
CHARLESTON

WELL LOCATION MAP
FILE NO. DOD-709-A

+ Denotes location of well on United States Topographic Maps, scale 1 to 62,500, latitude and longitude lines being represented by border lines as shown.

- Denotes one inch spaces on border line of original tracing.



654

STATE OF WEST VIRGINIA
DEPARTMENT OF MINES
OIL AND GAS DIVISION

WELL RECORD

Permit No. AB 79 A

~~Oil~~ or Gas Well (KIND)

Company W. D. Gribble
Address West Union, W. Va.
Farm J. I. Hiley Hrs Acres 118
Location (waters) Rush Run of Arnolds Creek
Well No. 1728 Elev. 1168
District Central County Doddridge
The surface of tract is owned in fee by J. I. Hiley Hrs
Central Station Address W. Va.
Mineral rights are owned by Same
Address _____

Drilling commenced May 9 1916
Drilling completed August 2 1916
Date Shot 1-8-40 From 2760 To 2766
With 40 Qts
Open Flow _____ /10ths Water in _____ Inch
_____ /10ths Merc. in _____ Inch
Volume _____ Cu. Ft.
Rock Pressure _____ lbs. _____ hrs.
Oil _____ bbls., 1st 24 hrs.
Fresh water _____ feet _____ feet
Salt water _____ feet _____ feet

Casing and Tubing	Used in Drilling	Left in Well	Packers
Size			
16			Kind of Packer
13			
10	720	None	Size of
8 1/4	1175	1175	
6 3/4	2065	2065	Depth set
5 3/16			
3			Perf. top
2			Perf. bottom
Liners Used			Perf. top
			Perf. bottom

CASING CEMENTED _____ SIZE _____ No. Ft. _____ Date _____
COAL WAS ENCOUNTERED AT _____ FEET _____ INCHES
_____ FEET _____ INCHES FEET _____ INCHES
_____ FEET _____ INCHES FEET _____ INCHES

Formation	Color	Hard or Soft	Top	Bottom	Oil, Gas or Water	Depth Found	Remarks
Pittsburgh Coal			780	782			
Big Dunkard			1045	1186			
Maxson			1850	1885			
Big Injun			2105	2197	Gas	2177-2183 2190-2197	
Gantz			2350	2475			
Gordon			2756	2766	Gas	2760-2766	
Total Depth				2838			

C



was on 71440