


Latitude 39° 10'

Longitude 80° 45'

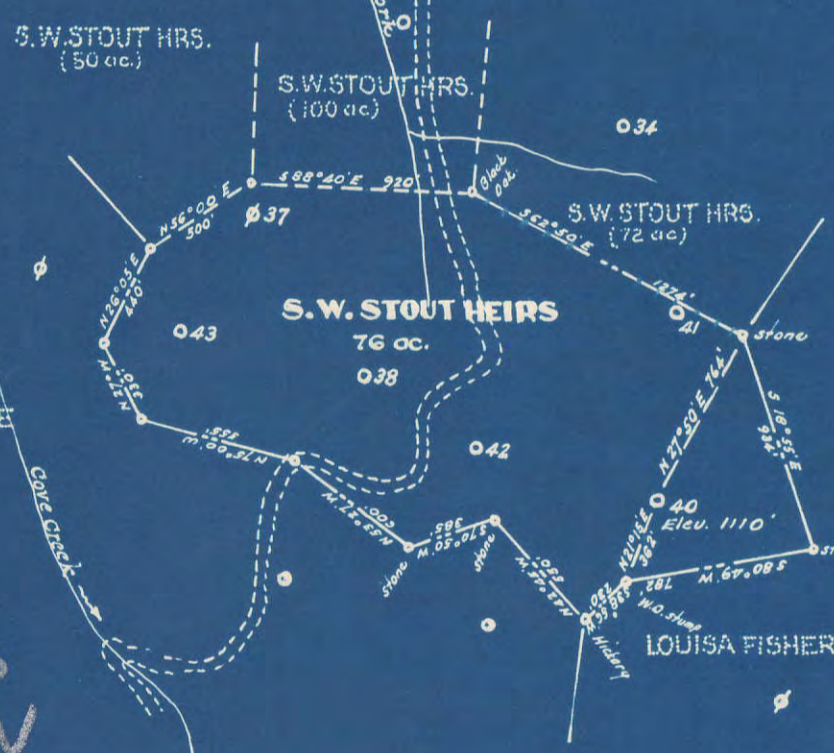

0.43 S
0.10 W

New Location
 Drill Deeper
 Abandonment

NOTE: No coal mines in this vicinity - Tract shown is a part of a tract of 1427 acres combined in one oil & gas lease.

Company SAM BEREN
 Address Marietta, Ohio
 Farm S.W. Stout Heirs 76 ac. Tract
 Tract Acres 76.0 Lease No. _____
 Well (Farm) No. Forty Serial No. _____
 Elevation (Spirit Level) 1110'
 Quadrangle Holbrook
 County Doddridge District Southwest
 Engineer [Signature]
 Engineer's Registration No. 1227
 File No. _____ Drawing No. _____
 Date Sept. 1948 Scale 1" = 800'

STATE OF WEST VIRGINIA
 DEPARTMENT OF MINES
 OIL AND GAS DIVISION
 CHARLESTON

WELL LOCATION MAP
 FILE NO. DOD-715-A

+ Denotes location of well on United States Topographic Maps, scale 1 to 62,500, latitude and longitude lines being represented by border lines as shown.

- Denotes one inch spaces on border line of original tracing.



STATE OF WEST VIRGINIA
DEPARTMENT OF MINES
OIL AND GAS DIVISION

609

WELL RECORD

Permit No. 715-A

Oil or Gas Well X (KIND)

Company Joe Rubin, S. Beren, & H. Strauss
Address 2008 E. 7th St. Parkersburg, W. Va.
Farm S. W. Stout Acres 1427A
Location (waters) _____
Well No. #40 Elev. 1110
District Southwest County Doddridge
The surface of tract is owned in fee by _____
Address _____
Mineral rights are owned by _____
Address _____
Drilling commenced _____
Drilling completed January 30, 1901
Date Shot _____ From _____ To _____
With _____
Open Flow _____ /10ths Water in _____ Inch
_____ /10ths Merc. in _____ Inch
Volume _____ Cu. Ft.
Rock Pressure _____ lbs. _____ hrs.
Oil _____ bbls., 1st 24 hrs.
Fresh water _____ feet _____ feet
Salt water _____ feet _____ feet

Casing and Tubing Size	Used in Drilling	Left in Well	Packers
16			Kind of Packer
13			No Record
10	575		Size of
8 1/4	1270		Depth set
6 5/8	2060	2060	Perf. top
5 3/16	2157	2157	Perf. bottom
3			Perf. top
2			Perf. bottom
Liners Used			Perf. top
			Perf. bottom

CASING CEMENTED _____ SIZE _____ No. Ft. _____ Date _____
COAL WAS ENCOUNTERED AT _____ FEET _____ INCHES
_____ FEET _____ INCHES FEET _____ INCHES
_____ FEET _____ INCHES FEET _____ INCHES

Formation	Color	Hard or Soft	Top	Bottom	Oil, Gas or Water	Depth Found	Remarks
R Rock Cave			800	950			
Cow Run 1st			1270	1320			
1st Salt			1450	1545			
Water			1460				
Maxon			1940	1965			
Pencil Cave			2000	2005			
Big Lime			2020	2062			
Big Injun			2062	2177			
Gordon Stray			2718	2730			
Gordon			2730	2734			
Oil			2730				
Total Depth				2755			