


Latitude 39 15'

Longitude 80 30'

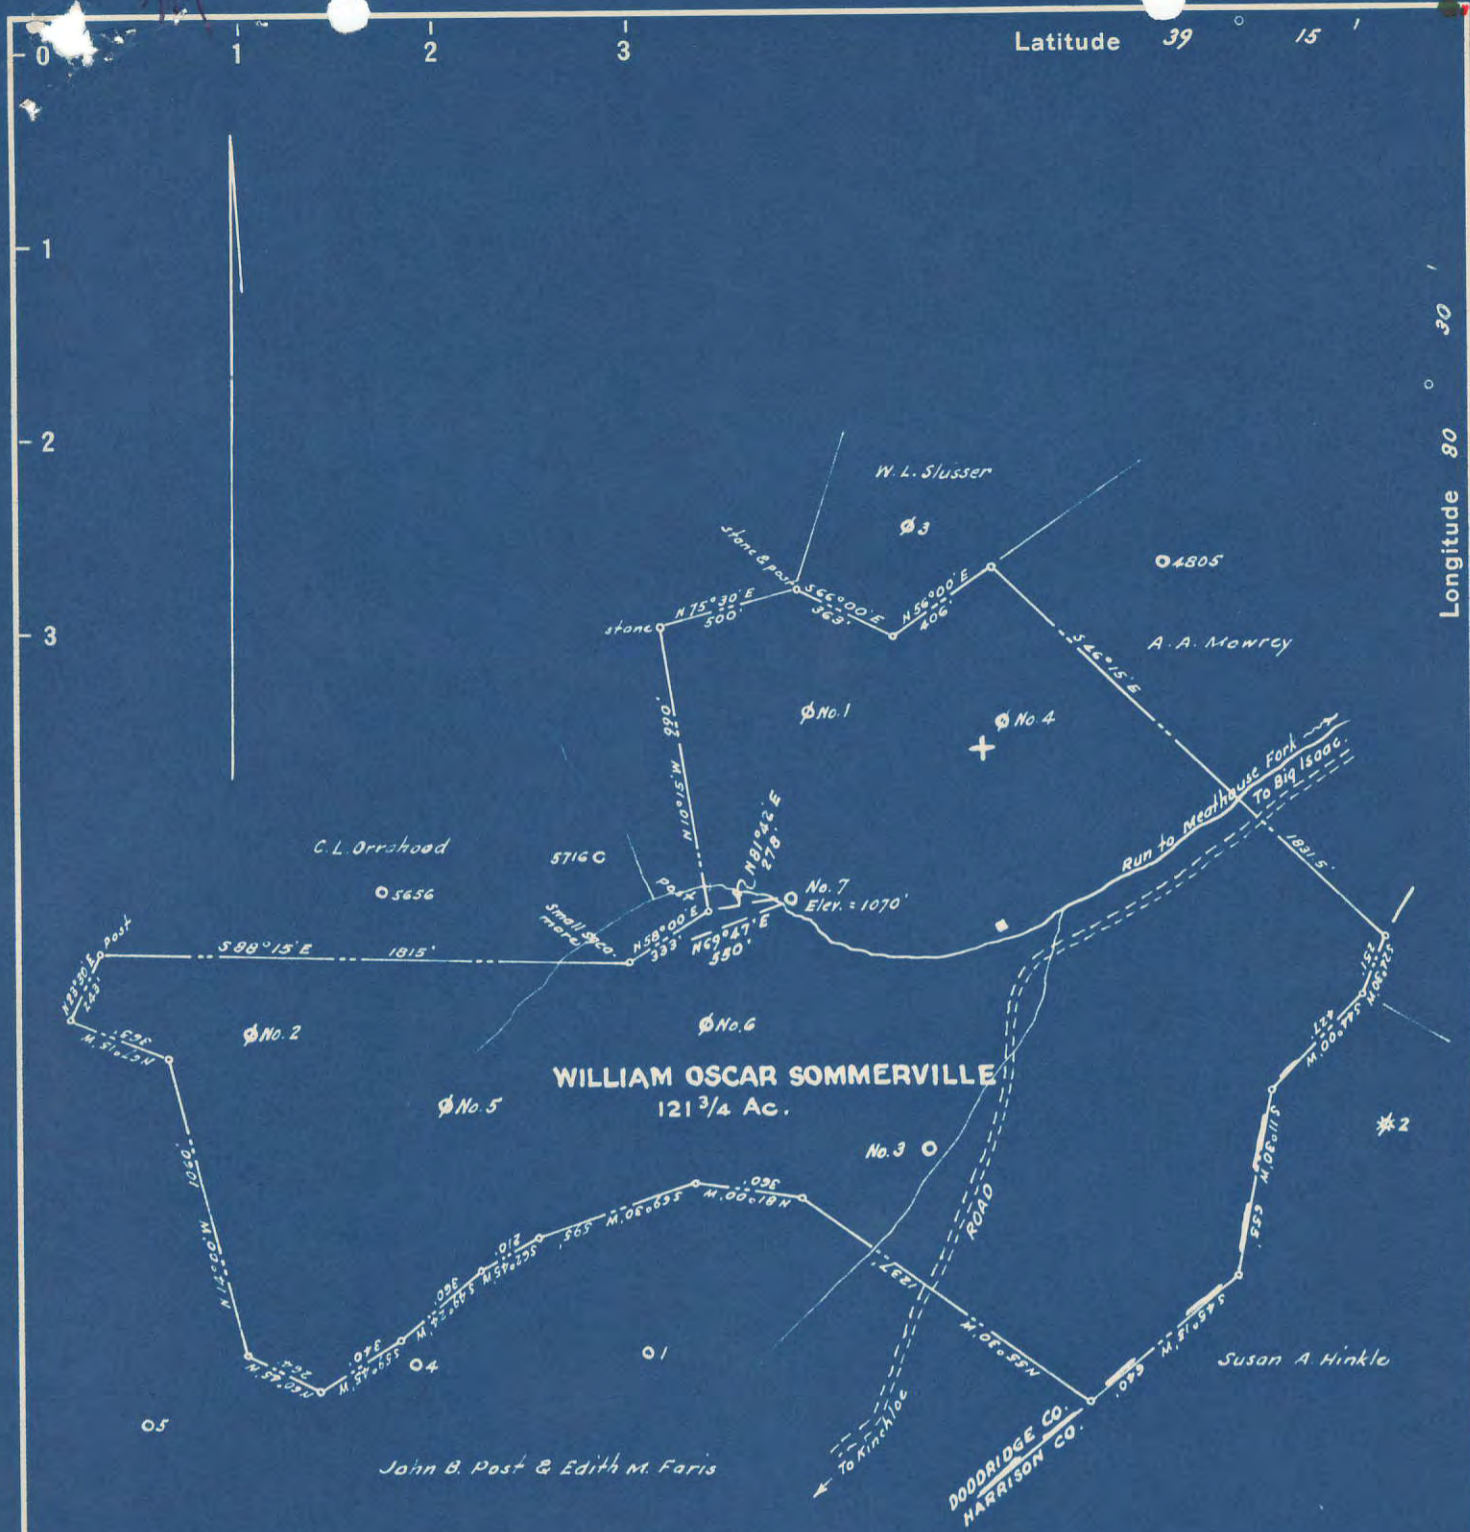

WILLIAM OSCAR SOMMERVILLE
121 3/4 Ac.

NOTE: Oil and gas lists tract as containing 121.75 acres. Corrected survey by Freeman for coal sale describes tract as 150.5 acres. Coal sold by W.O. Sommerville to Randolph and Lawther July 3, 1909. Recorded in Doddridge County Deed Book 32, page 147. Undivided 1/2 interest conveyed by C.A.F. Randolph to Lucian Lawther, June 8, 1931. See Deed Book No. 106, page 138. Coal ownership now vested in Estate of Lucian Lawther, Salem, West Va. (Delinquent 1948 taxes) Surface owned by Dr. H.C. Orrahood, Big Isaac, West Va.

3.81 S
2.55 W

New Location
Drill Deeper
Abandonment

Company C.R. DELAY
 Address Hamlin, West Va.
 Farm William Oscar Sommerville
 Tract _____ Acres 150.5 Lease No. _____
 Well (Farm) No. seven Serial No. _____
 Elevation (Spirit Level) 1070
 Quadrangle Vadis
 County Doddridge District Greenbriar
 Engineer W. H. [Signature]
 Engineer's Registration No. 1227
 File No. _____ Drawing No. _____
 Date January, 1949 Scale 1" = 660'

STATE OF WEST VIRGINIA
DEPARTMENT OF MINES
OIL AND GAS DIVISION
CHARLESTON

WELL LOCATION MAP
FILE NO. DOD-724-A #7

+ Denotes location of well on United States Topographic Maps, scale 1 to 62,500, latitude and longitude lines being represented by border lines as shown.
 - Denotes one inch spaces on border line of original tracing.



STATE OF WEST VIRGINIA
DEPARTMENT OF MINES
OIL AND GAS DIVISION

607

WELL RECORD

Permit No. 721A

Oil or Gas Well X (KIND)


Company South Penn Natural Gas Co.
 Address Parkersburg, W. Va.
 Farm W. O. Somerville Acres 160
 Location (waters) _____
 Well No. _____ Elev. 1070
 District Greenbrier County Doddridge
 The surface of tract is owned in fee by _____
 Address _____
 Mineral rights are owned by _____
 Address _____
 Drilling commenced Nov 22, 1929
 Drilling completed _____
 Date Shot _____ From _____ To _____
 With _____
 Open Flow _____ /10ths Water in _____ Inch
 _____ /10ths Merc. in _____ Inch
 Volume _____ Cu. Ft.
 Rock Pressure _____ lbs. _____ hrs.
 Oil 20 bbls., 1st 24 hrs.
 Fresh water _____ feet _____ feet
 Salt water _____ feet _____ feet

Casing and Tubing	Used in Drilling	Left in Well	Packers
Size			
16			Kind of Packer
13			
10		156	Size of
8 1/4		752	
6 3/8		2032	Depth set
5 3/16			
3			Perf. top
2			Perf. bottom
Liners Used			Perf. top
			Perf. bottom

CASING CEMENTED _____ SIZE _____ No. Ft. _____ Date _____
 COAL WAS ENCOUNTERED AT _____ FEET _____ INCHES
 _____ FEET _____ INCHES FEET _____ INCHES
 _____ FEET _____ INCHES FEET _____ INCHES

Formation	Color	Hard or Soft	Top	Bottom	Oil, Gas or Water	Depth Found	Remarks
Native Coal			<u>175</u>				
Pgh Coal			493	500			
Dunkard Sand			985	996			
1st Salt			1377	1543			
2nd Salt			1568	1605			
Maxon Sand			1790	1796			
Big Lime			1829	1849			
Big Injun			1935	2035			
Squaw Sand			2040	2120			
Berea Sand			2155	2175			
Gantz Sand			2256	2282			
Fifty Foot			2450	2473			
Thirty Foot			2490	2520			
Stray Sand			2536	2559			
Oil			2543	2549			
Oil			2552	2552			
Total Depth			2567				
Initial Production							
Gordon Sand							25 bbls

DATE SHOT
 11-9-1929
 6-13-1939
 30
 2543 2553

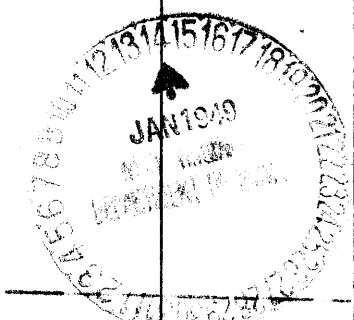

(Over)

MAR 17 1949