

Latitude 39° 25'

Longitude 80° 30'

L.E. Kyle  
26a

Toneas  
82a

W.S. Hutson  
55a

Solomon Fr Jm  
193a

558  
El. 1256\*

Anthony Hill  
73a

Solomon Frum  
307a

D.S. Smith  
362a

New Location   
Drill Deeper   
Abandonment

Map Sh. 45 S 5 E 2 FB 545 P 7

Company Hope Natural Gas Co.

Address Clarksburg, W. Va.

Farm W.S. Hutson

Tract \_\_\_\_\_ Acres 55 Lease No. 630

Well (Farm) No. \_\_\_\_\_ Serial No. 558

Elevation (Spirit Level) 1256'

Quadrangle Centerpoint

County Doddridge District McClellan

Engineer Wm Powers

Engineer's Registration No. 900

File No. \_\_\_\_\_ Drawing No. \_\_\_\_\_

Date 1-26-49 Scale 1" = 30 P

STATE OF WEST VIRGINIA  
DEPARTMENT OF MINES  
OIL AND GAS DIVISION  
CHARLESTON

### WELL LOCATION MAP

FILE NO. DOD-725-A

+ Denotes location of well on United States Topographic Maps, scale 1 to 62,500, latitude and longitude lines being represented by border lines as shown.

- Denotes one inch spaces on border line of original tracing.



J99

STATE OF WEST VIRGINIA  
DEPARTMENT OF MINES  
OIL AND GAS DIVISION

WELL RECORD

Permit No. 725-A


Oil or Gas Well (KIND)

Company Hope Natural Gas Company.  
 Address 445 West Main St. Clarksburg, W. Va.  
 Farm W.S. Hutson Acres 55  
 Location (waters) \_\_\_\_\_  
 Well No. 558 Elev. 1256  
 District McClellan County Doddrige  
 The surface of tract is owned in fee by \_\_\_\_\_  
 Address \_\_\_\_\_  
 Mineral rights are owned by \_\_\_\_\_  
 Address \_\_\_\_\_  
 Drilling commenced May 30, 1904  
 Drilling completed July 20, 1904  
 Date Shot \_\_\_\_\_ From \_\_\_\_\_ To \_\_\_\_\_  
 With \_\_\_\_\_  
 Open Flow \_\_\_\_\_ /10ths Water in \_\_\_\_\_ Inch  
 \_\_\_\_\_ /10ths Merc. in \_\_\_\_\_ Inch  
 Volume \_\_\_\_\_ Cu. Ft.  
 Rock Pressure \_\_\_\_\_ lbs. \_\_\_\_\_ hrs.  
 Oil \_\_\_\_\_ bbls., 1st 24 hrs.  
 Fresh water none recorded feet \_\_\_\_\_ feet  
 Salt water none recorded feet \_\_\_\_\_ feet

Casing and Tubing	Used in Drilling	Left in Well	Packers
Size			
16			Kind of Packer
13			
10	310	Pulled	Size of
8 1/4	1510	Pulled	
6 3/4	2440	2440	Depth set
5 3/16	2926	2926	
3			Perf. top
2	3118	Pulled	Perf. bottom
Liners Used			Perf. top
			Perf. bottom

CASING CEMENTED \_\_\_\_\_ SIZE \_\_\_\_\_ No. Ft. \_\_\_\_\_ Date \_\_\_\_\_  
5" set in 6 bags cement.  
 COAL WAS ENCOUNTERED AT 900 FEET 120 INCHES  
 \_\_\_\_\_ FEET \_\_\_\_\_ INCHES FEET \_\_\_\_\_ INCHES  
 \_\_\_\_\_ FEET \_\_\_\_\_ INCHES FEET \_\_\_\_\_ INCHES

Formation	Color	Hard or Soft	Top	Bottom	Oil, Gas or Water	Depth Found	Remarks
Coal			900	910			
Dunkard			1332	1360			
Salt sand			1795	2045			
Maxon			2085	2095			
Little Lime			2095	2140			
Pencil cave			2145	2150			
Big Lime			2150	2245			
Big Injun			2245	2345			
Fifty foot			2810	2850			
Thirty foot			2906	2946			
Stray			2981	2996			
Gordon			2998	3032	gas	2999 3003-8	
Fourth			3035	3047	gas	3037	
Total depth				3092			

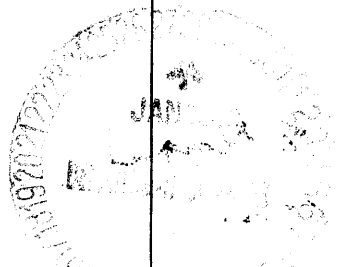

(Over)

MAR 11 1949

Formation	Color	Hard or Soft	Top	Bottom	Oil, Gas or Water	Depth Found	Remarks

Date January 25, 1949, 19

APPROVED Hope Natural Gas Company., Owner

By \_\_\_\_\_

(Title)

*JAD*

McClellan District, Doddridge County, W. Va.  
 By Hope Natural Gas Co., 445 W. Main St., Clarksburg, W. Va.  
 Abandoned under permit Mod-.....-A7

On 55 acres.

Elevation, 1256' L.

Drilling commenced May 30, 1904; completed July 20, 1904.

No water recorded.

10" casing, 310' (pulled); 8 1/4", 1510' (pulled); 6", 2440'; 5", 2926';  
 2" tubing, 3118' (pulled).

5" casing set in 6 bags cement.

Coal was encountered at 900-910'.

Gas well. Abandonment reported to Dept. of Mines Jan. 25, 1949.

Record to RCT from Mrs. Griffith March 17, 1949. Old File No. 599.

	Top.	Bottom.
Coal	900	910
Dunkard Sand	1332	1360
Salt Sand	1795	2045
Maxton Sand	2085	2095
Little Lime	2095	2140
Pencil Cove	2145	2150
Big Lime	2150	2245
Big Injun Sand	2245	2345
Fifty-foot Sand	2810	2850
Thirty-foot Sand	2906	2946
Stray Sand	2981	2996
Gordon Sand (gas, 2999, 3007-08')	2998	3032
Fourth Sand (gas, 3037')	3035	3047
Total depth		3092