

Latitude 39°17'30"

80°35'00"

Longitude

7.5'
+

Topo Location

7.5' Loc. 1.28S 15' Loc. 4.16S
1.25W (calc.) 1.25W

Company _____

Farm D.S. Morris #1


15' Quad Centerville 30
(sec.)

7.5' Quad SALEM

District GREENBRIER

WELL LOCATION PLAT

County 017 Permit 30724

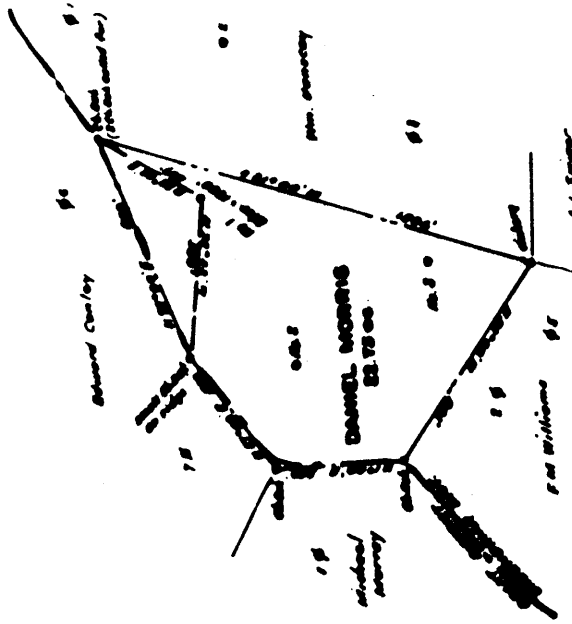

Oil & surface owned by James
 Smith, No. 1, Auburn, La.

New Location
 Drill Deeper
 Abandonment

Company C. B. DALRY
 Address Madison, W. Va.
 Farm Daniel Morris
 Tract Acres 23.33 Lease No. _____
 Well (Farm) No. 1 Serial No. _____
 Elevation (Spill Level) 118

STATE OF WEST VIRGINIA
 DEPARTMENT OF LANDS
 OIL AND GAS DIVISION
 CHARLESTON

WELL LOCATION MAP
 FILE NO. DOD-721-A

† Denotes location of well on United States
 Map, sheets 1 to 62,500, 1-



STATE OF WEST VIRGINIA
DEPARTMENT OF MINES
OIL AND GAS DIVISION

619

WELL RECORD

Permit No. 706-A

Oil or Gas Well X
(KIND)

Company South Penn Natural Gas Co.
Address Parkersburg, W. Va.
Farm Daniel Morris Acres 22
Location (waters) _____
Well No. 1 Elev. _____
District Greenbrier County Doddridge
The surface of tract is owned in fee by _____
Address _____
Mineral rights are owned by _____
Address _____
Drilling commenced _____
Drilling completed Nov. 16, 1902
Date Shot _____ From _____ To _____
With _____
Open Flow _____ /10ths Water in _____ Inch
_____ /10ths Merc. in _____ Inch
Volume _____ Cu. Ft.
Rock Pressure _____ lbs. _____ hrs.
Oil 100 bbls., 1st 24 hrs.
Fresh water _____ feet _____ feet
Salt water _____ feet _____ feet

Casing and Tubing	Used in Drilling	Left in Well	Packers
Size			Kind of Packer
16			
13			
10		298	Size of
8 1/4		1524	
6 5/8		2335	Depth set
5 3/16		2487	
3			Perf. top
2			Perf. bottom
Liners Used			Perf. top
			Perf. bottom

CASING CEMENTED _____ SIZE _____ No. Ft. _____ Date _____

COAL WAS ENCOUNTERED AT _____ FEET _____ INCHES
_____ FEET _____ INCHES FEET _____ INCHES
_____ FEET _____ INCHES FEET _____ INCHES

Formation	Color	Hard or Soft	Top	Bottom	Oil, Gas or Water	Depth Found	Remarks
Pgh Coal			1033	1040			
Dunkard Sand			1560	1612			
Big Injun			2385	2480			
Stray Sand			3092	3107			
Gordon Sand			3130	3138			
1st Pay			3134				
Total Depth				3157			
Initial Prod.							
Gordon Sand--100bbl.			Kind	PACKERS			
			Par. Disc.	Size	Depth	Date	
			" "	5-3/16" X 6-5/8X10	2465	1-28-28	
			" "	4 X 5-3/8"	3135	2-28-28	
Remarks:	<p>2X5-3/16 Larkin Packer 705' - 2" Tub. under packer. 121jts. above packer. Packer set in casing. Above pulled out - Dec. 1927 Jan. 28, 1928 Pulled and re-run 5-3/16" casing, using 1 jt. 5-3/16" casing below packer Run Feb. 1928 131 ft. - 4" X 4 1/2" F. J. Casing - Top 3007 6, ts. - 2 bottom jts performed on packer.</p>						
							Supt.

Greenbrier District, Doddridge County, W. Va.
 By South Penn Natural Gas Co., Parkersburg, W. Va.
 Abandoned under permit Dod-.....-A?
 On 22 acres.

Elevation,' L.

Drilling completed Nov. 16, 1902.

Oil, 100 bbis., 1st 24 hrs.

10" casing, 298'; 8 1/2" casing, 1524'; 6 3/4" casing, 2335'; 5 1/2" casing, 2487'; all left in.

Torpedo record: 1902, 20 qts., 3133'; 1904, 20 qts., 3133'.

Packer, Par. Disc, 5 1/2" x 6 3/4" x 10, set at 2465', 1-28-28; Par. Disc, 4 x 5 1/2", at 3138', Feb. 1928.

Remarks: 2x 5" Laskin packer, 705', 2" tubing under packer. 121 fts. above packer. Packer set in casing. Above pulled out Dec. 1927. Jan. 28, 1928, ~~minum~~ pulled and rerun 5 1/2" casing, using 1 jt. 5 1/2" casing below packer. Run Feb. 1928. 131 ft. 4 x 4 1/2" F. J. casing. Top, 3007'. 6 fts. - 2 bottom fts. perforated on packer.

Oil well. Record to Dept. of Mines stamped Jan. 19, 1949.

Record to NCF from Mrs. Griffith July 10, 1949. Old File No. 619.

	Top.	Bottom.
Pittsburgh Coal	1033	- 1040
Dunkard Sand	1560	- 1612
Big Injun Sand	2385	- 2400
Stray Sand	3022	- 3107
Gordon Sand (1st pay, 3134')	3130	- 3138
Total depth		3157

