

New Location
 Drill Deeper
 Abandonment

Company SAM BEREN
 Address Marietta, Ohio
 Farm William Doak
 Tract Acres 199 Lease No.
 Well (Farm) No. One Serial No.
 Elevation (Spirit Level) 1020
 Quadrangle West Union
 County Doddridge District Central
 Engineer *W. H. J.*
 Engineer's Registration No. 1227
 File No. Drawing No.
 Date Sept., 1948 Scale 1" = 800'

STATE OF WEST VIRGINIA
 DEPARTMENT OF MINES
 OIL AND GAS DIVISION
 CHARLESTON

WELL LOCATION MAP
 FILE NO. DOD-736-A

+ Denotes location of well on United States Topographic Maps, scale 1 to 62,500, latitude and longitude lines being represented by border lines as shown.

- Denotes one inch spaces on border line of original tracing.

WILLIAM DOAK NO. 1 WELL.

Central District, Doddridge County, W. Va.
 By Joe Rubin, S. Beren and W. Strauss, 2008 E. 7th St., Parkersburg, W. Va.
 Abandoned under permit Dod-.....-A?
 On 200 acres.

Elevation, L.

Drilling completed April 25, 1919.

10" casing, 385' (pulled); 8" , 1120' (pulled); 6" , 1480'; 5" , 1908'.

Hook wall packer, 5" x 6", set at 1908'.

Oil well. Record to Dept. of Mines stamped Feb. 28, 1949.

Record to RCT from Mrs. Griffith September 14, 1949. Old File No. 630.

	Top.	Bottom.
Pittsburgh Coal	650	- 655
Cow Run Sand, First	1105	- 1030
Cow Run Sand, Second	1086	- 1122
1st Salt Sand	1375	- 1423
2nd Salt Sand (water, 1455')	1450	- 1550
3rd Salt Sand	1550	- 1688
Maxton Sand	1798	- 1830
Little Lime	1852	- 1872
Pencil Cave	1872	- 1882
Big Lime	1882	- 1957
Big Injun Sand (oil, 1978-1986')	1957	- 2012
Total depth		2016



STATE OF WEST VIRGINIA
DEPARTMENT OF MINES
OIL AND GAS DIVISION

630

WELL RECORD

Permit No. 736 A

Oil or Gas Well X (KIND)

Company Joe Rubin, S. Beren, & H. Strauss
Address 2008 E. 7th St. Parkersburg, W. Va.
Farm William Doak Acres 200
Location (waters) _____
Well No. #1 Elev. 1020
District Central County Doddridge
The surface of tract is owned in fee by _____
Address _____
Mineral rights are owned by _____
Address _____


Casing and Tubing	Used in Drilling	Left in Well	Packers
Size			
16			Kind of Packery <u>H. W.</u>
13			Size of <u>5 3/16x</u>
10	<u>385</u>		<u>6 5/8</u>
8 1/4	<u>1120</u>		Depth set <u>1908</u>
6 5/8	<u>1480</u>	<u>1480</u>	
5 3/16	<u>1908</u>	<u>1908</u>	
3			Perf. top _____
2			Perf. bottom _____
Liners Used			Perf. top _____
			Perf. bottom _____

Drilling commenced _____
Drilling completed April 25, 1919
Date Shot _____ From _____ To _____
With _____
Open Flow /10ths Water in _____ Inch
/10ths Merc. in _____ Inch
Volume _____ Cu. Ft.
Rock Pressure _____ lbs. _____ hrs.
Oil _____ bbls., 1st 24 hrs.
Fresh water _____ feet _____ feet
Salt water _____ feet _____ feet

CASING CEMENTED _____ SIZE _____ No. Ft. _____ Date _____

COAL WAS ENCOUNTERED AT _____ FEET _____ INCHES
_____ FEET _____ INCHES _____ FEET _____ INCHES
_____ FEET _____ INCHES _____ FEET _____ INCHES

Formation	Color	Hard or Soft	Top	Bottom	Oil, Gas or Water	Depth Found	Remarks
Pgh Coal			650	655			
Cow Run 1st			1105	1030			
Cow Run 2nd			1086	1122			
1st Salt			1375	1423			
2nd Salt			1450	1550			
Water			1455				
3rd Salt			1550	1688			
Maxon			1798	1830			
Little Lime			1852	1872			
Pencil Cave			1872	1882			
Big L ₁ me			1882	1957			
Big Injun			1957	2012			
Oil			1978	1986			
Total Depth				2016			

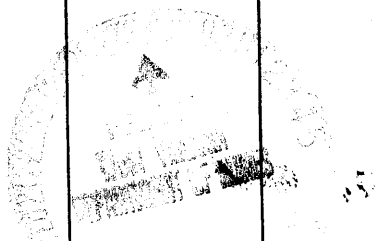

SEP 14 1949