

New Location
 Drill Deeper
 Abandonment

Company SAM BEREN
 Address Maricetta, Ohio
 Farm W. B. Maxwell
 Tract Acres 1725 Lease No. NE
 Well (Farm) No. 13 Serial No. _____
 Elevation (Spirit Level) 1140'
 Quadrangle Holbrook
 County Doddridge District Southwest
 Engineer W. B. Steel Jr.
 Engineer's Registration No. 1227
 File No. _____ Drawing No. _____
 Date Oct., 1948 Scale 1" = 800'

STATE OF WEST VIRGINIA
 DEPARTMENT OF MINES
 OIL AND GAS DIVISION
 CHARLESTON

WELL LOCATION MAP
 FILE NO. DOD-739-A

+ Denotes location of well on United States Topographic Maps, scale 1 to 62,500, latitude and longitude lines being represented by border lines as shown.
 - Denotes one inch spaces on border line of original tracing.



STATE OF WEST VIRGINIA
DEPARTMENT OF MINES
OIL AND GAS DIVISION

634

WELL RECORD

Permit No. 739 A


Oil or Gas Well (KIND)

Company Joe Rubin, S. Beren, H. Strauss
 Address 2008 E. 7th St. Parkersburg, W. Va.
 Farm W. B. Maxwell Acres 2400
 Location (waters) _____
 Well No. #13 Elev. 1140
 District Southwest County Doddridge
 The surface of tract is owned in fee by _____
 Address _____
 Mineral rights are owned by _____
 Address _____
 Drilling commenced _____
 Drilling completed July 26, 1913
 Date Shot _____ From _____ To _____
 With _____
 Open Flow _____ /10ths Water in _____ Inch
 _____ /10ths Merc. in _____ Inch
 Volume _____ Cu. Ft.
 Rock Pressure _____ lbs. _____ hrs.
 Oil _____ bbls., 1st 24 hrs.
 Fresh water _____ feet _____ feet
 Salt water _____ feet _____ feet

Casing and Va. Tubing	Used in Drilling	Left in Well	Packers
Size			
16			Kind of Packer <u>H.V.</u>
13			<u>5/8" x 5-3/16"</u>
10	376		Size of _____
8 1/4	1106	1106	
6 5/8	1835	1835	Depth set _____
5 3/16	1846	1846	
3			Perf. top _____
2			Perf. bottom _____
Liners Used			Perf. top _____
			Perf. bottom _____

CASING CEMENTED _____ SIZE _____ No. Ft. _____ Da _____
 COAL WAS ENCOUNTERED AT _____ FEET _____ INCHES
 _____ FEET _____ INCHES FEET _____ INCHES
 _____ FEET _____ INCHES FEET _____ INCHES

Formation	Color	Hard or Soft	Top	Bottom	Oil, Gas or Water	Depth Found	Remarks
Cow Run Sand			895	970			
1st Salt			1185	1280			
Water			1560				
Maxon			1571	1621			
Big Lime			1697	1795			
Keener			1795	1821			
Gas			1821				
Big Injun			1821	1893			
Gas			1872				
Berea			2040	2160			
Gantz			2235	2257			
Gordon Stray			2432	2450			
Water			2432				
Gordon			2468	2469			
Oil			2468				
Total Depth				2484			

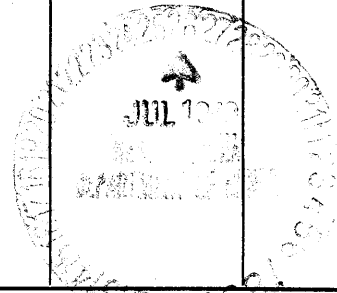

(Over) SEP 14 1949