

Company Hope Natural Gas Co.

Address Clarksburg, W. Va

Farm E. & O. Ashcraft

Tract _____ Acres 78 Lease No. 1900

Well (Farm) No. _____ Serial No. 726

Elevation (Spirit Level) 965'

Quadrangle Centerpoint

County Doddridge District McClellan

Engineer W.M. Bowers

Engineer's Registration No. 900

File No. _____ Drawing No. _____

Date 5-25-49 Scale 1" = 400'

STATE OF WEST VIRGINIA
DEPARTMENT OF MINES
OIL AND GAS DIVISION
CHARLESTON

WELL LOCATION MAP

FILE NO. DOD-743-A

+ Denotes location of well on United States Topographic Maps, scale 1 to 62,500, latitude and longitude lines being represented by border lines as shown.

- Denotes one inch spaces on border line of original tracing.



STATE OF WEST VIRGINIA
DEPARTMENT OF MINES
OIL AND GAS DIVISION

615

WELL RECORD

Permit No. 742 A


Oil or Gas Well (KIND)

Company Hope Natural Gas Company.
Address 445 West Main St. Clarksburg, W. Va.
Farm E & G Ashcraft Acres 78
Location (waters) _____
Well No. 726 Elev. 965
District McClellan County Doddridge
The surface of tract is owned in fee by _____
Address _____
Mineral rights are owned by _____
Address _____
Drilling commenced May 18, 1905
Drilling completed June 29, 1905
Date Shot _____ From _____ To _____
With _____
Open Flow /10ths Water in _____ Inch
/10ths Merc. in _____ Inch
Volume _____ Cu. Ft.
Rock Pressure _____ lbs. _____ hrs.
Oil _____ bbls., 1st 24 hrs.
Fresh water none recorded feet _____ feet
Salt water none recorded feet _____ feet

| Casing and Tubing | Used in Drilling | Left in Well | Packers |
|-------------------|------------------|--------------|----------------|
| Size | | | Kind of Packer |
| 16 | | | |
| 13 | | | |
| 10 | 250 | 250 | Size of |
| 8 1/4 | 935 | 935 | |
| 6 5/8 | | | Depth set |
| 5 3/16 | 2429 | 2429 | |
| 3 | | | Perf. top |
| 2 | | | Perf. bottom |
| Liners Used | | | Perf. top |
| | | | Perf. bottom |

NOT
CASING CEMENTED _____ SIZE _____ No. Ft. _____ Date _____
COAL WAS ENCOUNTERED AT 526 FEET 530 INCHES
_____ FEET _____ INCHES _____ FEET _____ INCHES
_____ FEET _____ INCHES _____ FEET _____ INCHES

| Formation | Color | Hard or Soft | Top | Bottom | Oil, Gas or Water | Depth Found | Remarks |
|-----------------|-------|--------------|------|--------|-------------------|-------------|---------|
| Pittsburgh Coal | | | 526 | 530 | | | |
| Little Dunkard | | | 910 | 950 | | | |
| Big Dunkard | | | 1080 | 1120 | | | |
| First Salt | | | 1300 | 1350 | | | |
| Second Salt | | | 1370 | 1500 | | | |
| Little Lime | | | 1788 | 1803 | ⊙ | | |
| Big Lime | | | 1808 | 1868 | | | |
| Big Injun | | | 1868 | 1960 | | | |
| Berea | | | 2095 | 2103 | | | |
| Fifty foot | | | 2400 | 2460 | | | |
| Thirty foot | | | 2540 | 2565 | | | |
| Gordon stray | | | 2613 | 2629 | show gas | 2628 | |
| Gordon | | | 2638 | 2665 | gas | 2654 | |
| Total depth | | | | 2665 | | | |

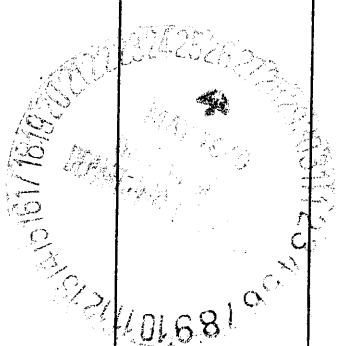

| Formation | Color | Hard or Soft | Top | Bottom | Oil, Gas or Water | Depth Found | Remarks |
|-----------|-------|--------------|-----|--------|-------------------|-------------|---------|
| | | | | | | | |

Date May 25, 1949, 19

APPROVED Hope Natural Gas Company., Owner

By _____

(Title) *JAM*

McClellan District, Doddridge County, W. Va.
 By Hope Natural Gas Co., 445 W. Main St., Clarksburg, W. Va.
 Abandoned under permit Dod-.....-A?

On 78 acres.

Elevation, 965' L.

Drilling commenced May 18, 1905; completed June 29, 1905.

No water recorded.

10" casing, 250'; 8 1/2", 935'; 5 1/2", 2429'; all left in.

Casing not cemented.

Coal was encountered at 526-530'.

Gas well. Abandonment reported to Dept. of Mines May 25, 1949.

Record to ROT from Mrs. Griffith July 10, 1949. Old File No. 615.

| | Top. | Bottom. |
|-------------------------------------|------|---------|
| Pittsburgh Coal | 526 | 530 |
| Little Darkard Sand | 910 | 950 |
| Big Darkard Sand | 1080 | 1120 |
| First Salt Sand | 1300 | 1350 |
| Second Salt Sand | 1370 | 1500 |
| Little Lime | 1788 | 1803 |
| Big Lime | 1808 | 1868 |
| Big Injun Sand | 1868 | 1960 |
| Berea Sand | 2095 | 2103 |
| Fifty-foot Sand | 2400 | 2460 |
| Thirty-foot Sand | 2580 | 2565 |
| Gordon Stray Sand (show gas, 2628') | 2613 | 2629 |
| Gordon Sand (gas, 2654') | 2638 | 2665 |
| Total, depth | | 2665 |