

2.33 S
4.40 W

Surface owned by Clifford & Colley Underwood.
 Address: Mr. Clifford Underwood, Shirley, W. Va.
 No Coal ever sold under this tract of land, if any, it belongs to the owners of the surface.

New Location
 Drill Deeper
 Abandonment

On 800' Map N37, Sqs. S 5 W 7.

Company Randall-Zogg Supply Co.
 Address Owensboro, Ky.
 Farm Jacob Underwood
 Tract _____ Acres 102 Lease No. WC
 Well (Farm) No. 11 Serial No. _____
 Elevation (Spirit Level) Floor - 1283.50
Ground - 1280.40
 Quadrangle Centerpoint
 County Doddridge District Grant
 Engineer A.L. Headley
 Engineer's Registration No. 2021
 File No. _____ Drawing No. _____
 Date Apr. 26th, 1949 Scale 1" = 400 Feet

STATE OF WEST VIRGINIA
 DEPARTMENT OF MINES
 OIL AND GAS DIVISION
 CHARLESTON

WELL LOCATION MAP
 FILE NO. DOD-749-A

+ Denotes location of well on United States Topographic Maps, scale 1 to 62,500, latitude and longitude lines being represented by border lines as shown.
 - Denotes one inch spaces on border line of original tracing.



STATE OF WEST VIRGINIA
DEPARTMENT OF MINES
OIL AND GAS DIVISION

642

AD 749 A

WELL RECORD

Permit No. _____

Oil or Gas Well **OIL**
(KIND)


Company **RANDALL-ZOGG SUPPLY COMPANY**
Address **BOX 526, CHARLESTON, 22 W. VA.**
Farm **Jacob Underwood** Acres **108**
Location (waters) **Coal Run of Little Flint Creek**
Well No. **Eleven (11)** Elev. **1072.57**
District **Grant** County **Doddridge**
The surface of tract is owned in fee by **Clifford & Colley Underwood** Address **Shirley, W. Va.**
Mineral rights are owned by **Clifford & Colley Underwood,** Address **Shirley, W. Va.**
Drilling commenced _____
Drilling completed _____
Date Shot **SEE BELOW** From _____ To _____
With _____
Open Flow /10ths Water in _____ Inch
/10ths Merc. in _____ Inch
Volume _____ Cu. Ft.
Rock Pressure _____ lbs. _____ hrs.
Oil _____ bbls., 1st 24 hrs.
Fresh water _____ feet _____ feet
Salt water _____ feet _____ feet

Casing and Tubing	Used in Drilling	Left in Well	Packers
Size			
16			Kind of Packer
13			
10	200'		Size of
8 1/4	1419'		
6 5/8	2238'	2238'	Depth set
5 3/16			
3			Perf. top
2	2409'	2409'	Perf. bottom
Liners Used			Perf. top
			Perf. bottom

CASING CEMENTED _____ SIZE _____ No. Ft. _____ Da _____

COAL WAS ENCOUNTERED AT **950** FEET _____ INCHES
_____ FEET _____ INCHES FEET _____ INCHES
_____ FEET _____ INCHES FEET _____ INCHES

Formation	Color	Hard or Soft	Top	Bottom	Oil, Gas or Water	Depth Found	Remarks
Pittsburgh Coal			950'				
Big Injun Sand			2290'		Oil	2374'	
Total Depth				2409'			
SHOT RECORD							
	DATE OF SHOT		NO. QTS.	TOP OF SHOT			
	9-1-38		30	2373'			
	12-9-39		30	2372'			
	1-22-40		40	2376'			

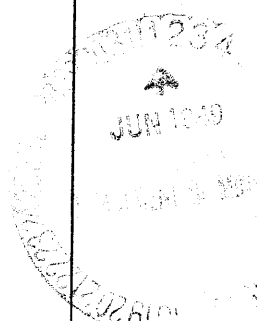

(Over) **SEP 14 1949**

Formation	Color	Hard or Soft	Top	Bottom	Oil, Gas or Water	Depth Found	Remarks

Date May 27th, 1948

APPROVED RANDALL ZOGG SUPPLY COMPANY, Owner

By [Signature]
(Title) Agent

JACOB UNDERWOOD NO. 11 WELL.

749A

Grant District, Doddridge County, W. Va.
 By Randall-Zogg Supply Co., Box 526, Charleston, 22, W. Va.
 Abandoned under permit Dod-.....-A?
 On 102 acres, on Coal Run of Little Flint Creek.
 Elevation, 1072.37' L.

#9700 5400

Surface and minerals owned by Clifford and Colley Underwood, Shirley, W. V.
 Date of completion, etc., not given.

Shot Sept. 1, 1898, with 30 qts., top of shot, 2373'; Dec. 9, 1899, with
 30 qts., top of shot, 2372'; and Jan. 22, 1905, with 40 qts., top of
 shot, 2374'.

10" casing, 200' (pulled); 8 $\frac{1}{4}$ " , 1419' (pulled); 6 $\frac{5}{8}$ " , 2238'; 2" tubing, 240'
 Coal was encountered at 950'.

Oil well. Record to Dept. of Mines dated May 27, 1949.

Record to RCT from Mrs. Griffith September 14, 1949. Old File No. 642.

Pittsburgh Coal
 Big Injun Sand (oil, 2374')
 Total depth

Top.	Bottom.
950 -	...
2290 -
	2409