

Surface owned by Charles Stewart Hrs.
 Address: Mrs. John Craig, 629. Mulberry Ave. Clarksburg, W. Va.
 No coal ever sold under this tract of land, if any, it belongs to the owners of the Surface.

New Location.
 Drill Deeper.
 Abandonment. On 800' Map N37. Sqs. 5 4 5 W 6-7.

Company Randall-Zogg Supply Co.
 Address Owensboro, Ky.
 Farm Charles Stewart
 Tract _____ Acres 446 1/2 Lease No. _____
 Well (Farm) Nos. 4, 27 & 29. Serial No. _____
 Elevation (Spirit Level) See wells above for Elev.
 Quadrangle Centerpoint
 County Doddridge District Grant
 Engineer A.S. Headley
 Engineer's Registration No. 2021
 File No. _____ Drawing No. _____
 Date Apr. 26th, 1949. Scale 1" = 800 Feet

STATE OF WEST VIRGINIA
 DEPARTMENT OF MINES
 OIL AND GAS DIVISION
 CHARLESTON

WELL LOCATION MAP

FILE NO. DOD-777-A #4
DOD-748-A #27
DOD-750-A-#29

+ Denotes location of well on United States Topographic Maps, scale 1 to 62,500, latitude and longitude lines being represented by border lines as shown.

- Denotes one inch spaces on border line of original tracing.



626

STATE OF WEST VIRGINIA
DEPARTMENT OF MINES
OIL AND GAS DIVISION

WELL RECORD

Permit No. 250-A

Oil or Gas Well **OIL**
(KIND)


Company RANDALL-ZOGG SUPPLY COMPANY
Address BOX 526, CHARLESTON, 22 W. VA.
Farm Charles Stewart Acres 446 1/2
Location (waters) Big Flint Creek
Well No. Twenty Nine (29) Elev. 214.80
District Grant County Doddridge
The surface of tract is owned in fee by Charles Stewart Esq.
e/o Mrs. John Craig Address Clarksburg, W. Va.
Mineral rights are owned by Charles Stewart Esq.
e/o Mrs. John Craig Address Clarksburg, W. Va.
Drilling commenced _____
Drilling completed _____
Date Shot SEE BELOW From _____ To _____
With _____
Open Flow /10ths Water in _____ Inch
/10ths Merc. in _____ Inch
Volume _____ Cu. Ft.
Rock Pressure _____ lbs. _____ hrs.
Oil _____ bbls., 1st 24 hrs.
Fresh water _____ feet _____ feet
Salt water _____ feet _____ feet

Casing and Tubing	Used in Drilling	Left in Well	Packers
Size			
16			Kind of Packer
13			
10	303'		Size of
8 1/4	1166'	1166'	
6 5/8	1934'	1934'	Depth set
5 3/16			
3			Perf. top
2	2102'	2102'	Perf. bottom
Liners Used			Perf. top
			Perf. bottom

CASING CEMENTED _____ SIZE _____ No. Ft. _____

COAL WAS ENCOUNTERED AT 670 FEET 48 INCHES
____ FEET _____ INCHES FEET _____ INCHES
____ FEET _____ INCHES FEET _____ INCHES

Formation	Color	Hard or Soft	Top	Bottom	Oil, Gas or Water	Depth Found	Remarks
Pittsburgh	Coal		670'	674'			
Big Lime			1912'	1990'			
Big Injun			1990'	2091'	OIL	1999'	
Total Depth				2102'	OIL	2084'	
SHOT RECORD							
	<u>DATE SHOT</u>		<u>NO. QTS.</u>	<u>TOP OF SHOT</u>			
	8-7-06		20	2084'			
	4-22-08		20	1999'			
	6-19-08		20	1999'			
	6-25-08		24	2000'			

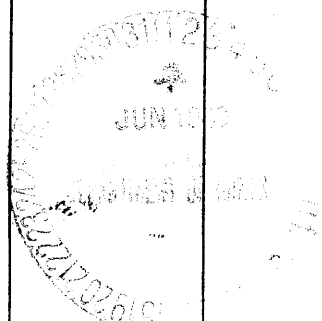

(Over)

AUG 10 1949

CHARLES STEWART NO. 29 WELL.

Grant District, Doddridge County, W. Va.
 By Randall-Zogg Supply Co., Box 526, Charleston, 22, W. Va.
 Abandoned under permit Dod-.....-A?
 On 46 1/2 acres, on Big Flint Creek.
 Elevation, 974.80' L.

Surface and minerals owned by Charles Stewart Heirs, (Mrs. John Craig,
 Clarksburg, W. Va.

Shot Aug. 7, 1906, with 20 qts., top of shot, 2084'; Apr. 22, 1908,
 with 20 qts., top of shot, 1999'; June 19, 1908, with 20 qts.,
 top of shot, 1999'; June 28, 1909, with 24 qts., top of shot, 2000'.
 10" casing, 303' (pulled); 8 1/2", 1166'; 6 3/8", 1994'; 2" tubing, 2102'.
 Coal was encountered at 670-674'.

Oil well. Abandonment reported to Dept. of Mines May 27, 1949.
 Record to RCT from Mrs. Griffith Aug. 10, 1949. Old File No. 626.

	Top.	Bottom.
Pittsburgh Coal	670	674
Big Line	1912	1990
Big Injun Sand (oil, 1999 and 2084')	1990	2091
Total depth		2102