

New Location   
 Drill Deeper   
 Abandonment  Partial

Map sh. 58 S 18 E 4 F.B. 880 P 10-11

Company Hope Natural Gas Co.  
 Address Clarksburg, W. Va.  
 Farm Henrietta J. West  
 Tract \_\_\_\_\_ Acres 20 Lease No. 10283  
 Well (Farm) No. \_\_\_\_\_ Serial No. 2135  
 Elevation (Spirit Level) 1178'  
 Quadrangle Vadis  
 County Doddridge District Greenbrier  
 Engineer W. M. Powers  
 Engineer's Registration No. 900  
 File No. \_\_\_\_\_ Drawing No. \_\_\_\_\_  
 Date 4-19-49 Scale 1" = 20 P

STATE OF WEST VIRGINIA  
 DEPARTMENT OF MINES  
 OIL AND GAS DIVISION  
 CHARLESTON

**WELL LOCATION MAP**  
 FILE NO. DOD-751-A

+ Denotes location of well on United States Topographic Maps, scale 1 to 62,500, latitude and longitude lines being represented by border lines as shown.

- Denotes one inch spaces on border line of original tracing.



STATE OF WEST VIRGINIA  
DEPARTMENT OF MINES  
OIL AND GAS DIVISION

643

WELL RECORD

Permit No. 201 A


~~Oil~~ or Gas Well \_\_\_\_\_ (KIND)

Company Hope Natural Gas Company.  
 Address 445 West Main St. Clarksburg, W. Va.  
 Farm Henrietta J. West Acres 20  
 Location (waters) \_\_\_\_\_  
 Well No. 2135 Elev. 1178  
 District Greenbrier County Doddridge  
 The surface of tract is owned in fee by \_\_\_\_\_  
 Address \_\_\_\_\_  
 Mineral rights are owned by \_\_\_\_\_  
 Address \_\_\_\_\_  
 Drilling commenced March 2, 1911  
 Drilling completed April 28, 1911  
 Date Shot \_\_\_\_\_ From \_\_\_\_\_ To \_\_\_\_\_  
 With \_\_\_\_\_  
 Open Flow \_\_\_\_\_ /10ths Water in \_\_\_\_\_ Inch  
 \_\_\_\_\_ /10ths Merc. in \_\_\_\_\_ Inch  
 Volume \_\_\_\_\_ Cu. Ft.  
 Rock Pressure \_\_\_\_\_ lbs. \_\_\_\_\_ hrs.  
 Oil \_\_\_\_\_ bbls., 1st 24 hrs.  
 Fresh water none recorded feet \_\_\_\_\_ feet  
 Salt water none recorded feet \_\_\_\_\_ feet

Casing and Tubing	Used in Drilling	Left in Well	Packers
Size			Kind of Packer
16			
13			
10	190	190	Size of
8 3/4	1082	Pulled	
6 5/8	1936	1936	Depth set
5 3/16			
3			Perf. top
2	2897	2897	Perf. bottom
Liners Used			Perf. top
			Perf. bottom

CASING CEMENTED \_\_\_\_\_ NOT SIZE \_\_\_\_\_ No. Ft. \_\_\_\_\_ Date \_\_\_\_\_  
 COAL WAS ENCOUNTERED AT 210 FEET 36 INCHES  
520 FEET 84 INCHES FEET INCHES  
 FEET INCHES FEET INCHES

Formation	Color	Hard or Soft	Top	Bottom	Oil, Gas or Water	Depth Found	Remarks
Coal			210	213			
Pitts. Coal			520	527			
Little Dunkard			870	890			
Big Dunkard			1070	1095			
First Salt			1475	1580			
Amazon			1825	1880	gas	1855	
Pencil cave			1880	1886			
Big Lime			1886	1936			
Big Injun			1936	2080			
Berea			2310	2340			
Fifty foot			2515	2530			
Thirty foot			2550	2565			
Gordon stray			2580	2621	show gas	2605 2620	
Gordon			2630	2670	gas	2635	
Fourth			2680	2688			
Fifth			2841	2842	gas	2841	
Total depth				2897			

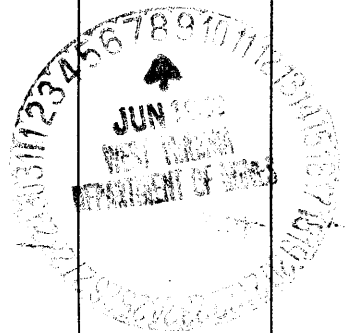

SEP 14 1949

Formation	Color	Hard or Soft	Top	Bottom	Oil, Gas or Water	Depth Found	Remarks

Date June 7, 1949., 19

APPROVED Hope Natural Gas Company., Own

By \_\_\_\_\_

(Title)  