

#13	4.02	W
#16	2.29	S
#20	3.72	W
#21	2.30	S
#22	2.22	W

Surface owned by Charles Stewart Hrs.
 Address: Mrs. John Craig, 629. Mulberry Ave. Clarksburg, W. Va.
 No Coal ever sold under this tract of land, if any, it belongs to the owners of the surface.

New Location...
 Drill Deeper...
 Abandonment...

On 800' Map N37. Sqs. 54-5 W6-7.

Company Randall-Zogg Supply Co.
 Address Owensboro, Ky.
 Farm Charles Stewart
 Tract _____ Acres 446 1/2 Lease No. WCO
 Well (Farm) Nos. 13, 16 & 20 Serial No. _____
 Elevation (Spirit Level) see Wells above for Elev
 Quadrangle Centerpoint
 County Doddridge District Grant
 Engineer B.E. Krebs
 Engineer's Registration No. 9.
 File No. _____ Drawing No. _____
 Date June 1st, 1949. Scale 1" = 800 Feet

STATE OF WEST VIRGINIA
 DEPARTMENT OF MINES
 OIL AND GAS DIVISION
 CHARLESTON

WELL LOCATION MAP
 DOD-756-A-#13
 FILE NO. DOD-757-A-#16
 DOD-758-A-#20

+ Denotes location of well on United States Topographic Maps, scale 1 to 62,500, latitude and longitude lines being represented by border lines as shown.

- Denotes one inch spaces on border line of original tracing.



662

STATE OF WEST VIRGINIA
DEPARTMENT OF MINES
OIL AND GAS DIVISION

WELL RECORD

Permit No. 112-758-A


Oil or Gas Well OIL
(KIND)

Company RANDALL-ZOGG SUPPLY COMPANY
 Address BOX 526, CHARLESTON, 22 W. VA.
 Farm Charles Stewart Acres 445 1/2
 Location (waters) Coal Run
 Well No. Thirteen (13) Elev. 792.55
 District Grant County Doddridge
 The surface of tract is owned in fee by Charles Stewart Hrs.
s/o Mrs. John Craig Address Clarksburg, W. Va.
 Mineral rights are owned by Charles Stewart Hairs,
s/o Mrs. John Craig Address Clarksburg, W. Va.
 Drilling commenced _____
 Drilling completed _____
 Date Shot SEE BELOW From _____ To _____
 With _____
 Open Flow _____ /10ths Water in _____ Inch
 _____ /10ths Merc. in _____ Inch
 Volume _____ Cu. Ft.
 Rock Pressure _____ lbs. _____ hrs.
 Oil _____ bbls., 1st 24 hrs.
 Fresh water _____ feet _____ feet
 Salt water _____ feet _____ feet

Casing and Tubing	Used in Drilling	Left in Well	Packers
Size			
16			Kind of Packer
13			
10	<u>530'</u>		Size of
8 1/2	<u>955'</u>		
6 1/2	<u>1830'</u>	<u>1830'</u>	Depth set
5 3/16	<u>754'</u>	<u>754'</u>	
3			Perf. top
2	<u>1928'</u>	<u>1928'</u>	Perf. bottom
Liners Used			Perf. top
			Perf. bottom

CASING CEMENTED _____ SIZE _____ No. Ft. _____ Dat _____
 COAL WAS ENCOUNTERED AT 490 FEET _____ INCHES
 _____ FEET _____ INCHES FEET _____ INCHES
 _____ FEET _____ INCHES FEET _____ INCHES

Formation	Color	Hard or Soft	Top	Bottom	Oil, Gas or Water	Depth Found	Remarks
Pittsburgh Coal			<u>490'</u>				
Big Injun Sand			<u>1820'</u>		<u>OIL & Gas</u>	<u>1904'</u>	
Total Depth				<u>1928'</u>	<u>OIL</u>	<u>1911'</u>	
SHOT RECORD							
	<u>DATE OF SHOT</u>		<u>NO. OF QTS.</u>		<u>TOP OF SHOT</u>		
	<u>12-30-97</u>		<u>16</u>		<u>1910'</u>		
	<u>5-28-99</u>		<u>24</u>		<u>1910'</u>		
	<u>2-27-02</u>		<u>30</u>		<u>1909'</u>		
	<u>5-20-04</u>		<u>40</u>		<u>1902'</u>		
	<u>6-2-08</u>		<u>60</u>		<u>1904'</u>		

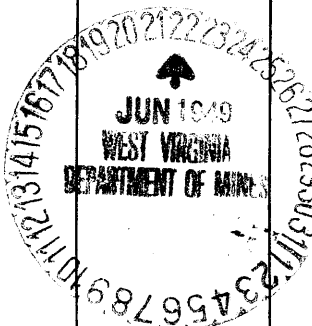

Grant District, Doddridge County, W. Va.
 By Randall-Zegg Supply Co., Box 526, Charleston, 22, W. Va.
 Abandoned under permit Dod-.....-A1
 On 44.6 $\frac{1}{2}$ acres, on Coal Run.
 Elevation, 792.55' L.

Surface and minerals owned by Charles Stewart Heirsm, Mrs. John Craig,
 Clarksburg, W. Va.

Shot Dec. 30, 1897, with 16 qts., at 1910'; March 28, 1899, with 24 qts.,
 at 1910'; Feb. 27, 1902, with 30 qts., at 1909'; May 20, 1904,
 with 40 qts., at 1902'; June 2, 1908, with 60 qts., at 1904' (all
 tops of shots).

10" casing, 390' (pulled); 8 $\frac{1}{2}$ " 955' (pulled); 6 $\frac{1}{2}$ " 1830'; 5 $\frac{1}{2}$ " 764';
 2" tubing, 1928'.

Coal was encountered at 490'.

Oil well. Record to Dept. of Mines dated June 15, 1949.

Record to RCT from Mrs. Friffith September 27, 1949. Old File No. 662.

	Top.	Bottom.
Pittsburgh Coal	490	...
Big Injun Sand (oil and gas, 1904'; oil, 1911')	1820
Total depth		1928